


N
 SCALE ~ 1" = 20'
 O = IRON PIPE

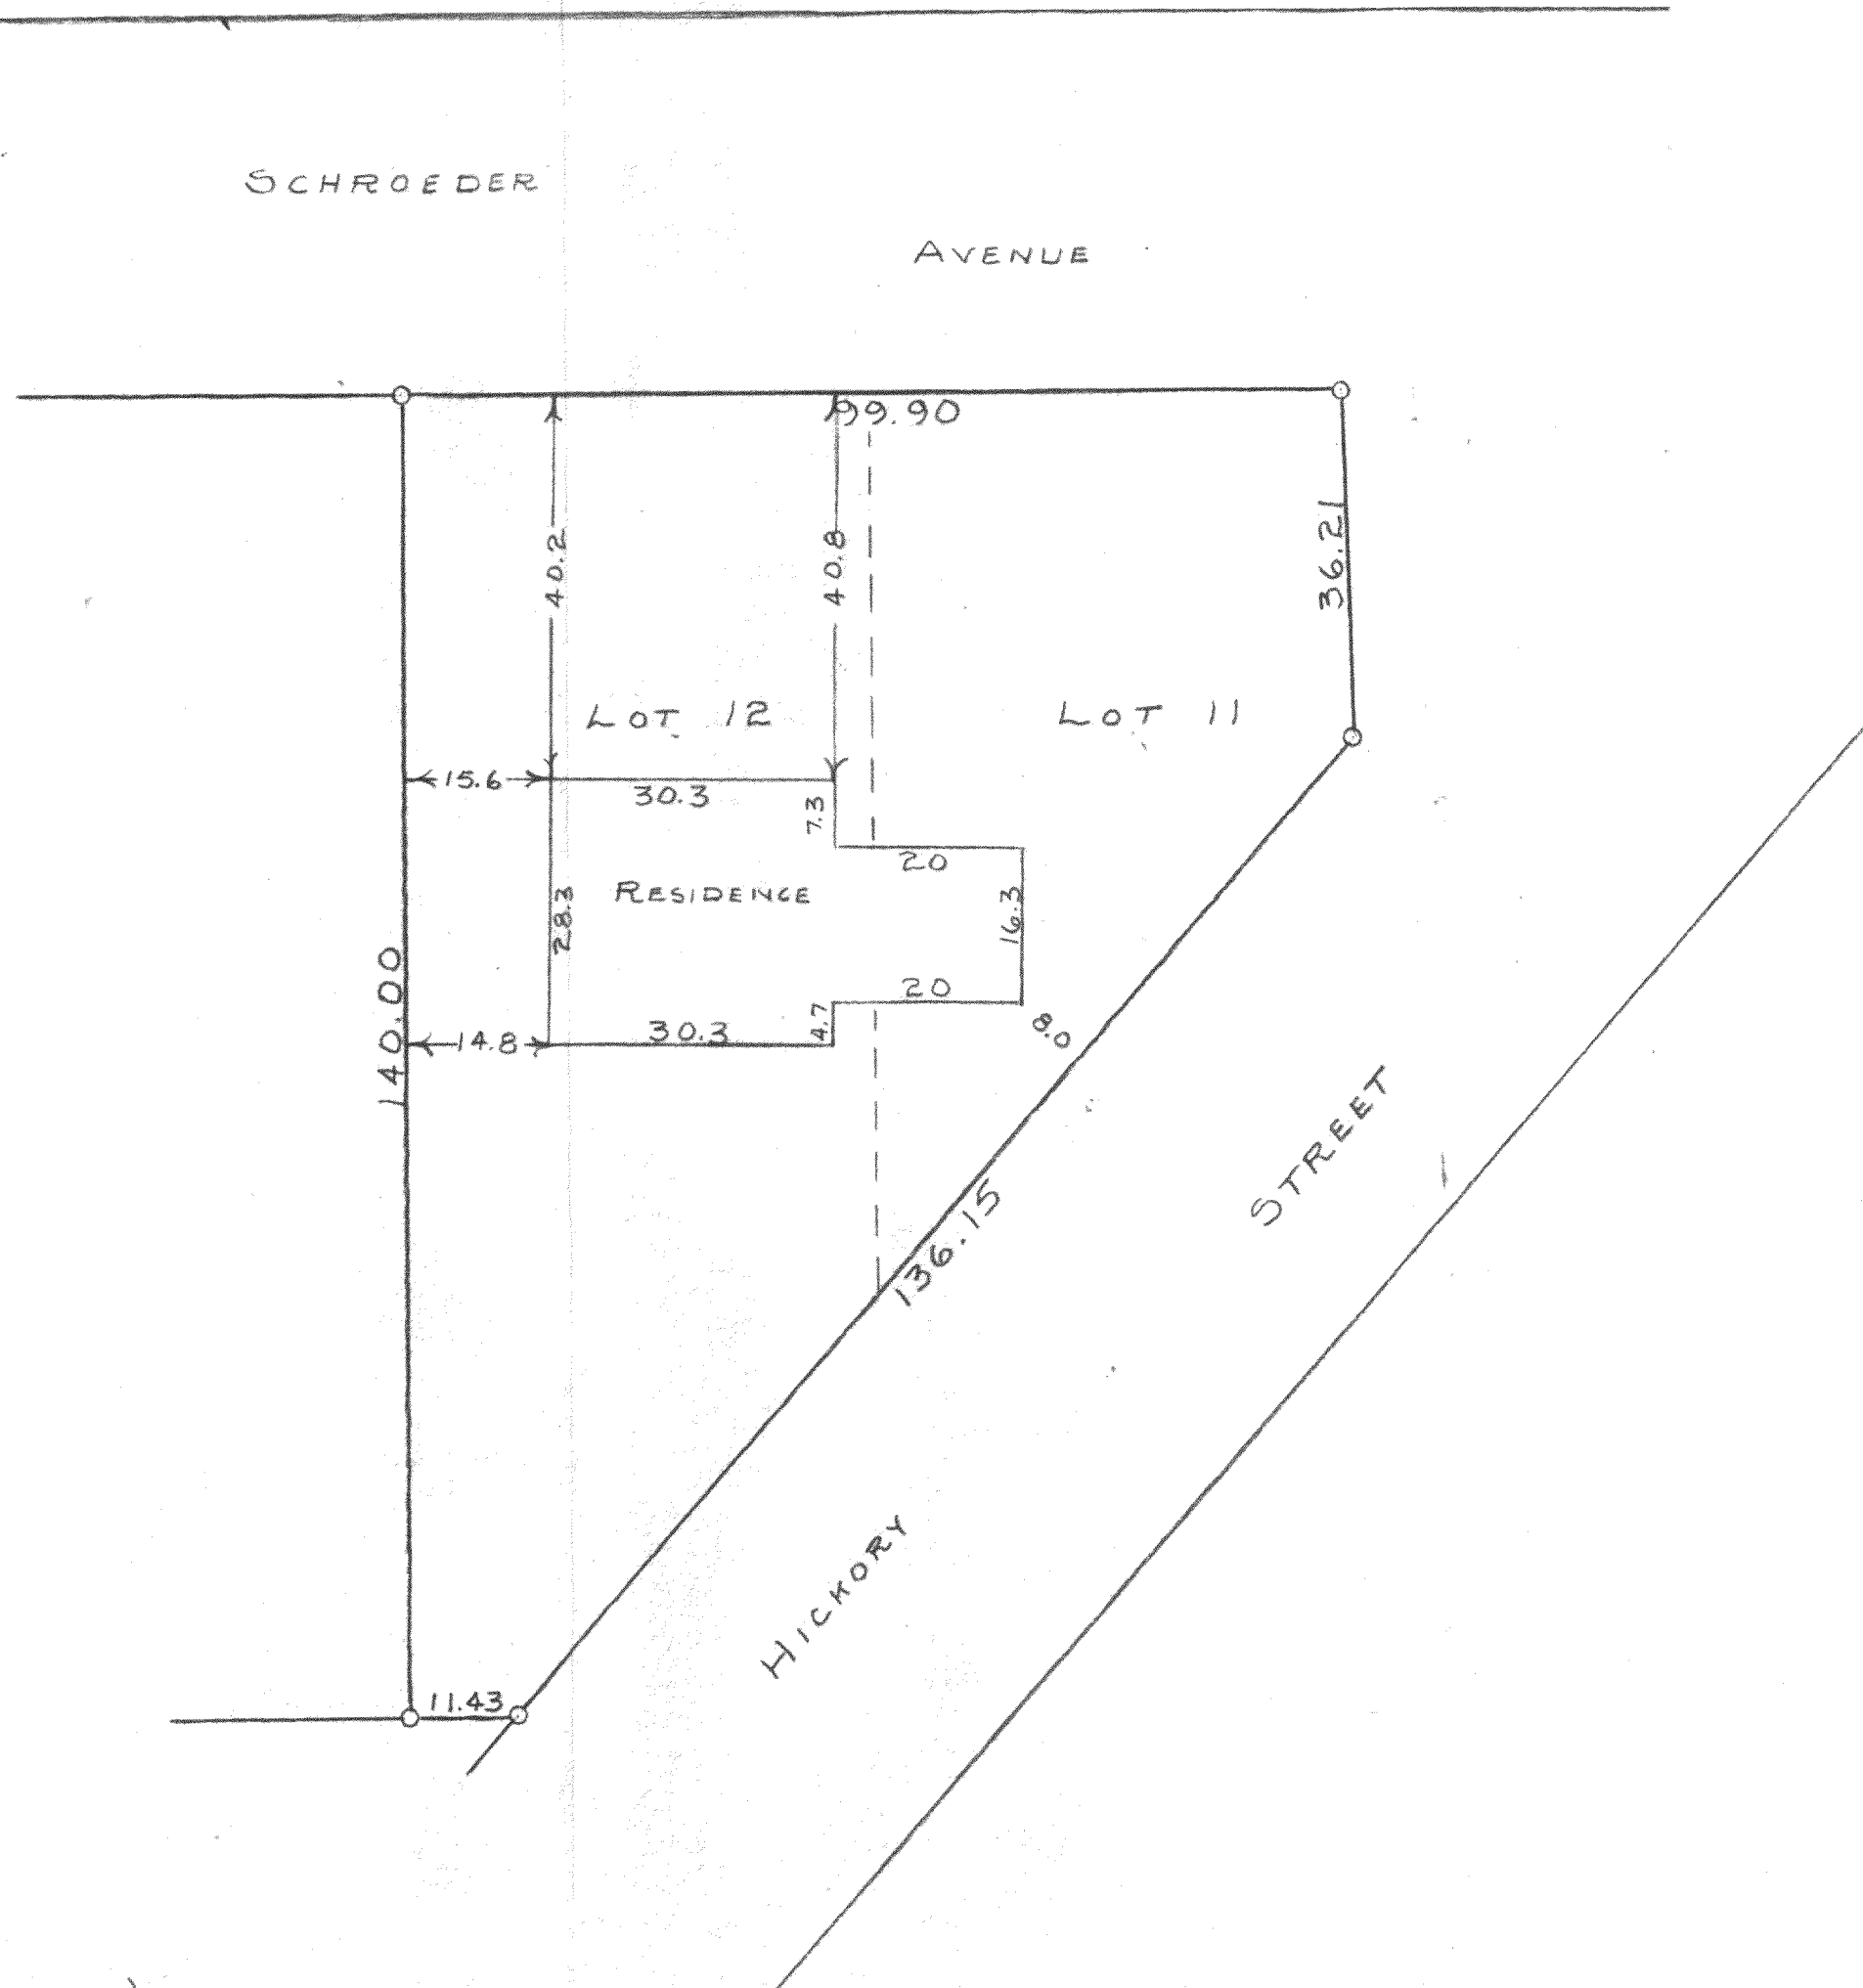

STATE OF WISCONSIN)^{SS}
 WALWORTH COUNTY)

I, GEORGE T. DUNHAM, DO HEREBY CERTIFY THAT I HAVE SURVEYED
 THE PROPERTY DESCRIBED AS FOLLOWS:

LOTS 11 AND 12, BLOCK NO. 6 OF INLET OAKS SUBDIVISION NO. 4
 LOCATED IN SECTION 15, T2N R16E OF WALWORTH COUNTY, WISCONSIN.
 AND THAT THE PLAT SHOWN ABOVE IS A CORRECT REPRESENTATION OF THE
 PROPERTY LINES AND OF THE IMPROVEMENTS LOCATED THEREON
 DEC. 4, 1959

George T. Dunham
 GEORGE T. DUNHAM
 WIS. LAND SURVEYOR No. S-306
 DELAVAN, WISCONSIN