
## WALWORTH COUNTY SURVEYING & MAPPING LAKE GENEVA, WISCONSIN

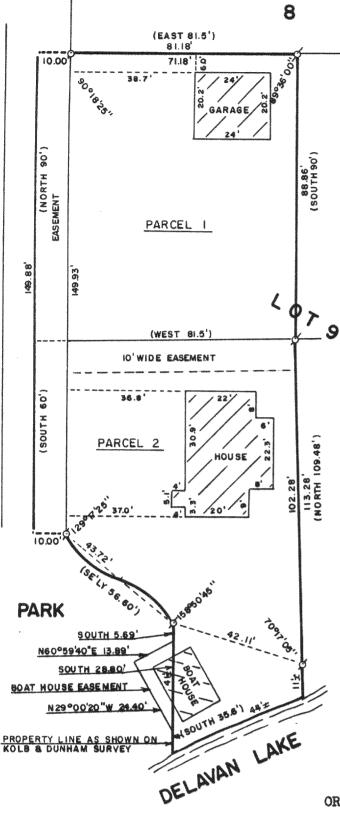


## PLAT OF SURVEY OF

PART OF LOT 9 OF CHICAGO CLUB, A SUBDIVISION LOCATED IN SECTION 31, T 2 N, R 16 E, WALWORTH COUNTY, WISCONSIN, DESCRIBED AS FOLLOWS:

PARCEL 1: COMMENCING AT THE NE CORNER OF LOT 9 OF CHICAGO CLUB SUBDIVISION, WHICH IS LOCATED IN SECTION 31, T 2 N, R 16 E, OF THE 4th P.M., THENCE WEST ALONG THE NORTH LINE OF SAID LOT 65 FEET TO THE PLACE OF BEGINNING; THENCE SOUTH 90 FEET; THENCE WEST 81.5 FEET; THENCE NORTH 90 FEET TO THE NORTH LINE OF SAID LOT 9; THENCE EAST ALONG THE SAID NORTH LINE 81.5 FEET TO THE PLACE OF BEGINNING.

PARCEL 2; COMMENCING AT THE NE CORNER OF LOT 9 OF CHICAGO CLUB SUBDIVISION, WHICH SUBDIVISION IS LOCATED IN SECTION 31, T 2 N, R 16 E, WALWORTH COUNTY, WISCONSIN, THENCE WEST ALONG THE NORTH LOT LINE OF SAID LOT 9, 65 FEET; THENCE SOUTH 90 FEET TO THE PLACE OF BEGINNING; THENCE WEST 81.5 FEET; THENCE SOUTH 60 FEET; THENCE SE'LY ALONG THE EDGE OF THE PARK, 56.60 FEET; THENCE SOUTH 27.6 FEET TO A POINT; THENCE CONTINUING SOUTH 8 FEET TO THE SHORE OF DELEVAN LAKE; THENCE NE'LY ALONG THE SHORE 37.2 FEET TO A POINT; THENCE NORTH 8 FEET; THENCE CONTINUING NORTH 101.48 FEET TO THE PLACE OF BEGINNING.

NOTE: REFER TO DEED OR GUARANTEE POLICY FOR BUILDING LINES AND EASEMENTS NOT SHOWN HEREON.

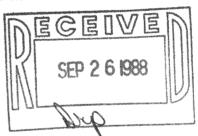

ORDERED BY: ROGER DUBA

1947 THORNWOOD AVENUE WILMETTE, ILLINOIS 60091



SCALE: 1"=30'

&-IRON PIPE FOUND o - IRON ROD FOUND

()-RECORDED AS

I HEREBY CERTIFY THAT I HAVE SURVEYED THE ABOVE DESCRIBED PROPERTY AND THAT THE ABOVE MAP IS A TRUE REPRESENTATION THEREOF AND SHOWS THE SIZE AND LOCATION OF THE PROPERTY, ITS EXTERIOR BOUNDARIES, THE LOCATION OF ALL VISIBLE STRUCTURES AND DIMENSIONS OF ALL ncipal buildings thereon, boundary fences, apparent easements and roadways and VISIBLE ENCROACHMENTS, IF ANY.

IS SURVEY IS MADE FOR THE EXCLUSIVE USE OF THE PRESENT OWNERS OF THE PROPERTY, AND ALSO THOSE WHO PURCHASE, MORTGAGE, OR GUARANTEE THE TITLE THERETO WITHIN ONE (1) YEAR FROM DATE HEREOF

BAERENWALD ROBERT M.

WISCONSIN REGISTERED LAND SURVEYOR, S-1508

DATE JOB NO. 0294

THIS IS NOT A CERTIFIED COPY UNLESS SEALED. NOTE: