
WALWORTH COUNTY SURVEYING & MAPPING LAKE GENEVA, WISCONSIN



PLAT OF SURVEY OF

LOT 7, ELOCK 13 OF DETMAR SUBDIVISION, LOCATED IN T 2 N, R 16 E, WALWORTH COUNTY, WISCONSIN.

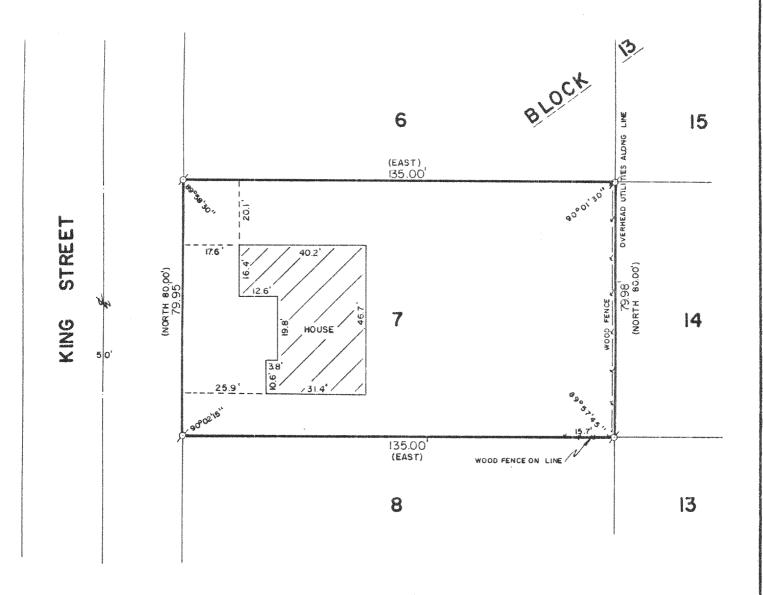

ORDERED BY: MIKRUT REALITY

RT. 5, BOX 453 LAKE GENEVA, WISCUNSIN 53147



SCALE: 1"=30'

Ø-IRON PIPE FOUND ()-RECORDED AS

THEREBY CERTIFY THAT THAVE SURVEYED THE ABOVE DESCRIBED PROPERTY AND THAT THE ABOVE MAP IS A TRUE REPRESENTATION THEREOF AND BHOWS THE SIZE AND LOCATION OF THE PHOPERTY, ITS EXTERIOR BOUNDARIES, THE LOCATION OF ALL VISIBLE STRUCTURES AND DIMENSIONS OF ALL PRINCIPAL BUILDINGS THEREON, BOUNDARY FENCES, APPARENT EASEMENTS AND ROADWAYS AND VISIBLE ENCROACHMENTS, IF ANY.

THIS SURVEY IS MADE FOR THE EXCLUSIVE USE OF THE PRESENT OWNERS OF THE PROPERTY, AND ALSO THOSE WHO PURCHASE, MORTDAGE, OR GLARANTEE THE TITLE THERETO WITHIN ONE (I) YEAR FROM DATE HEREOF.

ROBERT M. BAERENWALD

WISCONSIN REGISTERED LAND SURVEYOR, S-1508

DATE JOB NO. 1929

THIS IS NOT A CERTIFIED COPY UNLESS SEALED. NOTE: