


434



(0.00) = recorded distance
Bearings referenced to the assumed bearing
of North along the west line of Wells St.
Survey ordered by:
Edward F. Thompson
Attorney at Law
Clair Law Offices, S.C.
Delavan, WI 53115

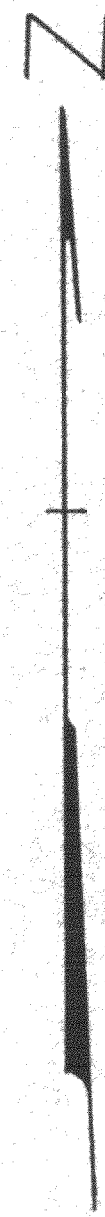

Lot 22 in Block 15, Delmar, a subdivision located in Section 27,
T 2 N, R 16 E, Walworth County, Wisconsin,
and that the plat shown hereon is a correct representation thereof and shows
the size and location of the property, its exterior boundaries, the location
of all visible structures and dimensions of all principal buildings thereon,
boundary fences, apparent easements, roadways and visible encroachments, if
any, and that I have surveyed the property hereon described, according to the
official records, to the best of my knowledge and belief.
May 23, 1989

216-1178

