
DUNHAM SURVEYING, S.C. SURVEYING & SUBDIVIDING


DELAVAN, WISCONSIN 53115

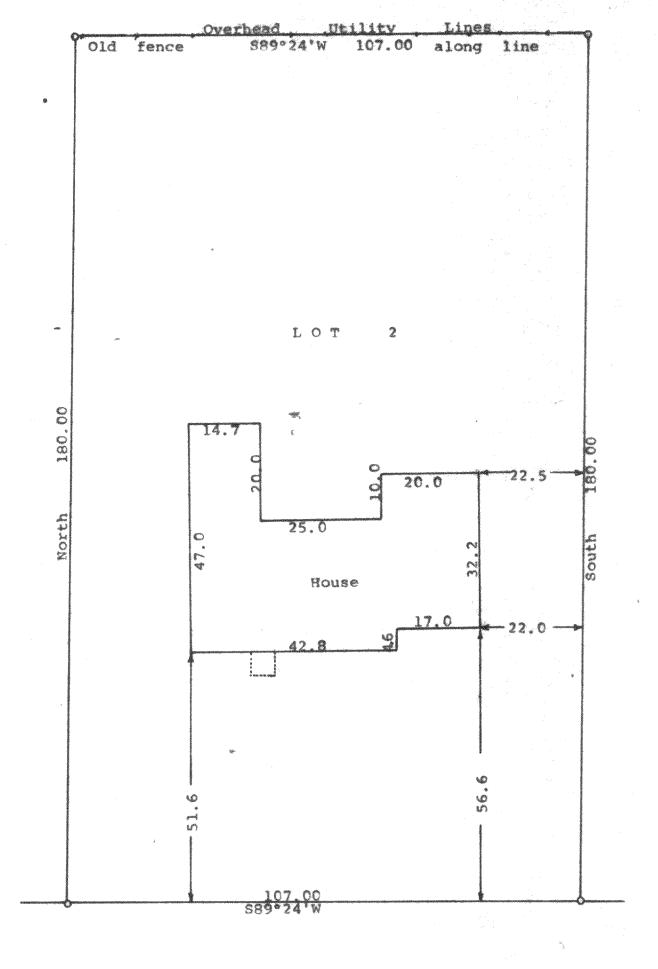

Scale - 1" = 20"o = 1" Iron Pipe Found Bearings shown are those on the recorded plat of Hansen's Subdivision Owner: Les Johnson Comus Drive Delavan, WI 53115

COMUS

DRIVE

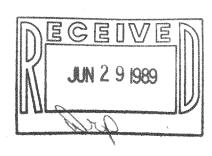

STATE OF WISCONSIN) SS COUNTY OF WALWORTH)

I, George T. Dunham, Surveyor, certify that I have surveyed the property described as follows:

Lot 2, Hansen's Subdivision located in Section 8, T 2 N, R 16 E, Walworth County, Wisconsin, and that the plat shown hereon is a correct representation thereof and shows

the size and location of the property, its exterior boundaries, the location of all visible structures and dimensions of all principal buildings thereon, boundary fences, apparent easements, roadways and visible encroachments, if any, and that I have surveyed the property hereon described, according to the official records, to the best of my knowledge and belief. November 1, 1988

George T. Dunham, Surveyor

216-1192

