

ABELL
SURVEYING & MAPPING
DELAVER, WISCONSIN 53115
414-728-6787

PLAT OF SURVEY OF

LOT 37, BLOCK 7, INLET OAKS SUBDIVISION NO. 4,
LOCATED IN SECTION 15, T2N, R16E, WALWORTH COUNTY,
WISCONSIN.

ORDERED BY: KEEFE REAL ESTATE
704 MAIN STREET
LAKE GENEVA, WI. 53147

EAVES AND GUTTER EXTEND 1.7' FROM HOUSE,
GUTTER EXTENDS 0.4' OVER LOT LINE.


HOUSE

GRAVEL
DRIVE

0.16 ACRES

BLOCK


FOUND IRON PIPE 0.93' N.E. OF
CORNER ON LINE

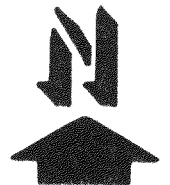

SCALE - 1"=20'

LEGEND

- Ø - IRON PIPE FOUND
- - IRON ROD SET
- () - RECORDED AS

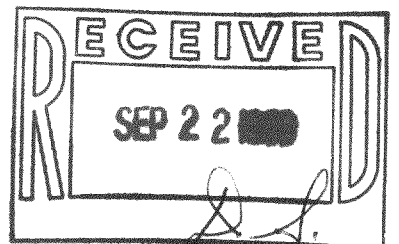

I HEREBY CERTIFY THAT I HAVE SURVEYED THE ABOVE
DESCRIBED PROPERTY AND THAT THE ABOVE MAP IS A
TRUE REPRESENTATION THEREOF AND SHOWS THE SIZE
AND LOCATION OF THE PROPERTY, ITS EXTERIOR
BOUNDARIES, THE LOCATION OF ALL VISIBLE STRUCTURES
AND DIMENSIONS OF ALL PRINCIPAL BUILDINGS THEREON,
BOUNDARY FENCES, APPARENT EASEMENTS, ROADWAYS AND
VISIBLE ENCROACHMENTS, IF ANY, TO THE BEST OF MY
KNOWLEDGE AND BELIEF.
THIS SURVEY IS MADE FOR THE USE OF THE PRESENT
OWNERS OF THE PROPERTY, AND ALSO THOSE WHO
PURCHASE, MORTGAGE, OR GUARANTEE THE TITLE THERETO
WITHIN ONE (1) YEAR FROM THE DATE HEREOF.

David F. Abell

DAVID F. ABELL
WISCONSIN REGISTERED LAND SURVEYOR, S-1596

August 10, 1989

DATE JOB NUMBER - 89163

NOTE: THIS IS NOT A CERTIFIED COPY UNLESS SEALED.