


CEDAR POINT DRIVE

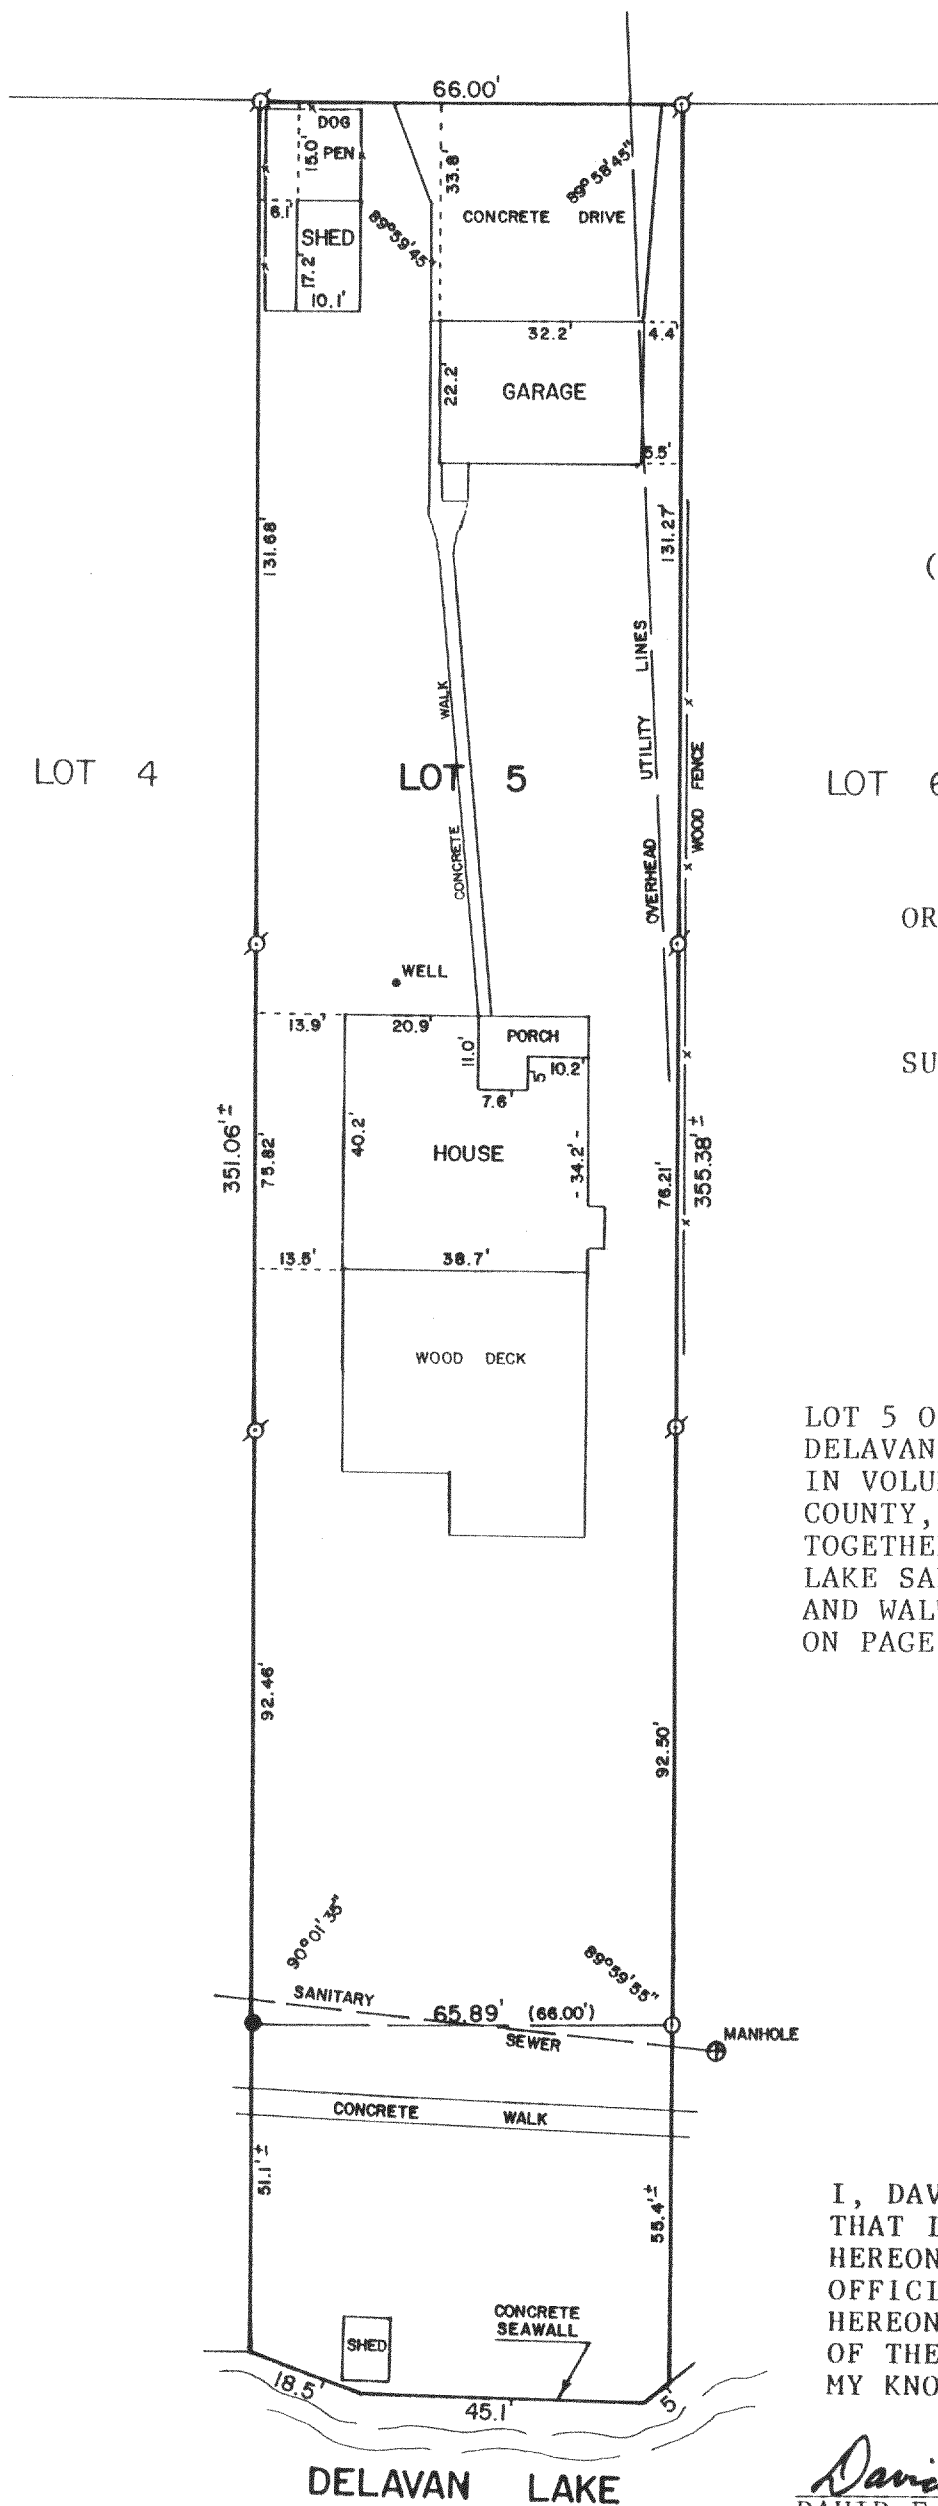

SCALE - 1"=30'

LEGEND


- Ø - IRON PIPE FOUND
- - IRON ROD FOUND
- - IRON PIPE SET, IRON PIPE FOUND 4-2-90
- () - RECORDED AS

ORDERED BY: CENTURY 21 - SKANDIA REALTY
312 S. 7th STREET
DELAVAN, WI. 53115

SURVEYED BY: ABELL SURVEYING & MAPPING
1140 SEQUOIA STREET
DELAVAN, WI. 53115

PLAT OF SURVEY OF

LOT 5 OF CEDAR POINT SUBDIVISION, TOWNSHIP OF DELAVAN, ACCORDING TO THE PLAT THEREOF RECORDED IN VOLUME 6 OF PLATS ON PAGES 47, WALWORTH COUNTY, WISCONSIN. TOGETHER WITH AN EASEMENT GRANTED TO THE DELAVAN LAKE SANITARY DISTRICT OF THE TOWNS OF DELAVAN AND WALWORTH RECORDED IN VOLUME 86 OF RECORDS ON PAGE 84 AS DOCUMENT NUMBER 660118.

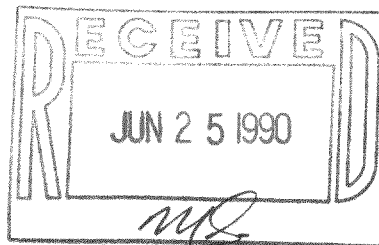

I, DAVID F. ABELL, DO HEREBY CERTIFY THAT I HAVE SURVEYED THE PROPERTY HEREON DESCRIBED ACCORDING TO THE OFFICIAL RECORDS AND THAT THE PLAT HEREON IS A CORRECT REPRESENTATION OF THE PROPERTY LINES TO THE BEST OF MY KNOWLEDGE AND BELIEF.

David F. Abell

DAVID F. ABELL
WISCONSIN REGISTERED LAND SURVEYOR, S-1596

DATE *Sept. 23, 1988* JOB NUMBER - 88226
NOTE: THIS IS NOT A CERTIFIED COPY UNLESS SEALED.

REVISED: APRIL 2, 1990
ORDERED BY: MUTUAL SAVINGS BANK
5300 S. 76th ST.
GEENDALE, WI. 53129

Tax # FC-5

216-1259