

**ABELL**  
**SURVEYING & MAPPING**  
 DELAVAN, WISCONSIN 53115  
 414-728-6737

100.04' (100')  
 (50')  
 OVERHEAD UTILITY LINES 50.01'  
 89°28'  
 90°32'  
 148.88'  
 149.07'  
 50.00'  
 50.02' (50')  
 50.00'  
 89°45'  
 89°15'

**BLOCK 4**

19

20  
 0.17 AC.


**BREEZY STREET**  
 (THIRD STREET)

**SUMNER STREET**

METAL LOCATOR DETECTED METAL OBJECT UNDER WATER AND ICE, OBJECT COULD NOT BE DUG UP AT THIS TIME.

LOT 20, BLOCK 4 OF INLET OAKS SUBDIVISION NO. 3,  
LOCATED IN T2N,R16E, WALWORTH COUNTY, WISCONSIN.

ORDERED BY: GODFREY, NESHEK & WORTH  
11 N. WISCONSIN ST.  
ELKHORN, WI. 53121

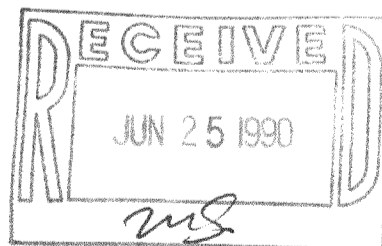

LEGEND

Ø - IRON PIPE FOUND  
○ - IRON ROD SET  
( ) - RECORDED AS

I HEREBY CERTIFY THAT I HAVE SURVEYED THE ABOVE DESCRIBED PROPERTY AND THAT THE ABOVE MAP IS A TRUE REPRESENTATION THEREOF AND SHOWS THE SIZE AND LOCATION OF THE PROPERTY, ITS EXTERIOR BOUNDARIES, THE LOCATION OF ALL VISIBLE STRUCTURES AND DIMENSIONS OF ALL PRINCIPAL BUILDINGS THEREON, BOUNDARY FENCES, APPARENT EASEMENTS, ROADWAYS AND VISIBLE ENCROACHMENTS, IF ANY, TO THE BEST OF MY KNOWLEDGE AND BELIEF.

THIS SURVEY IS MADE FOR THE USE OF THE PRESENT OWNERS OF THE PROPERTY, AND ALSO THOSE WHO PURCHASE, MORTGAGE, OR GUARANTEE THE TITLE THERETO WITHIN ONE (1) YEAR FROM DATE HEREOF.

*David F. Abell*  
DAVID F. ABELL  
WISCONSIN REGISTERED LAND SURVEYOR, S-1596

DATE January 10, 1990 JOB NUMBER = 89272  
NOTE: THIS IS NOT A CERTIFIED COPY UNLESS SEALED.

Tax # FIN3-103A

216-1270