


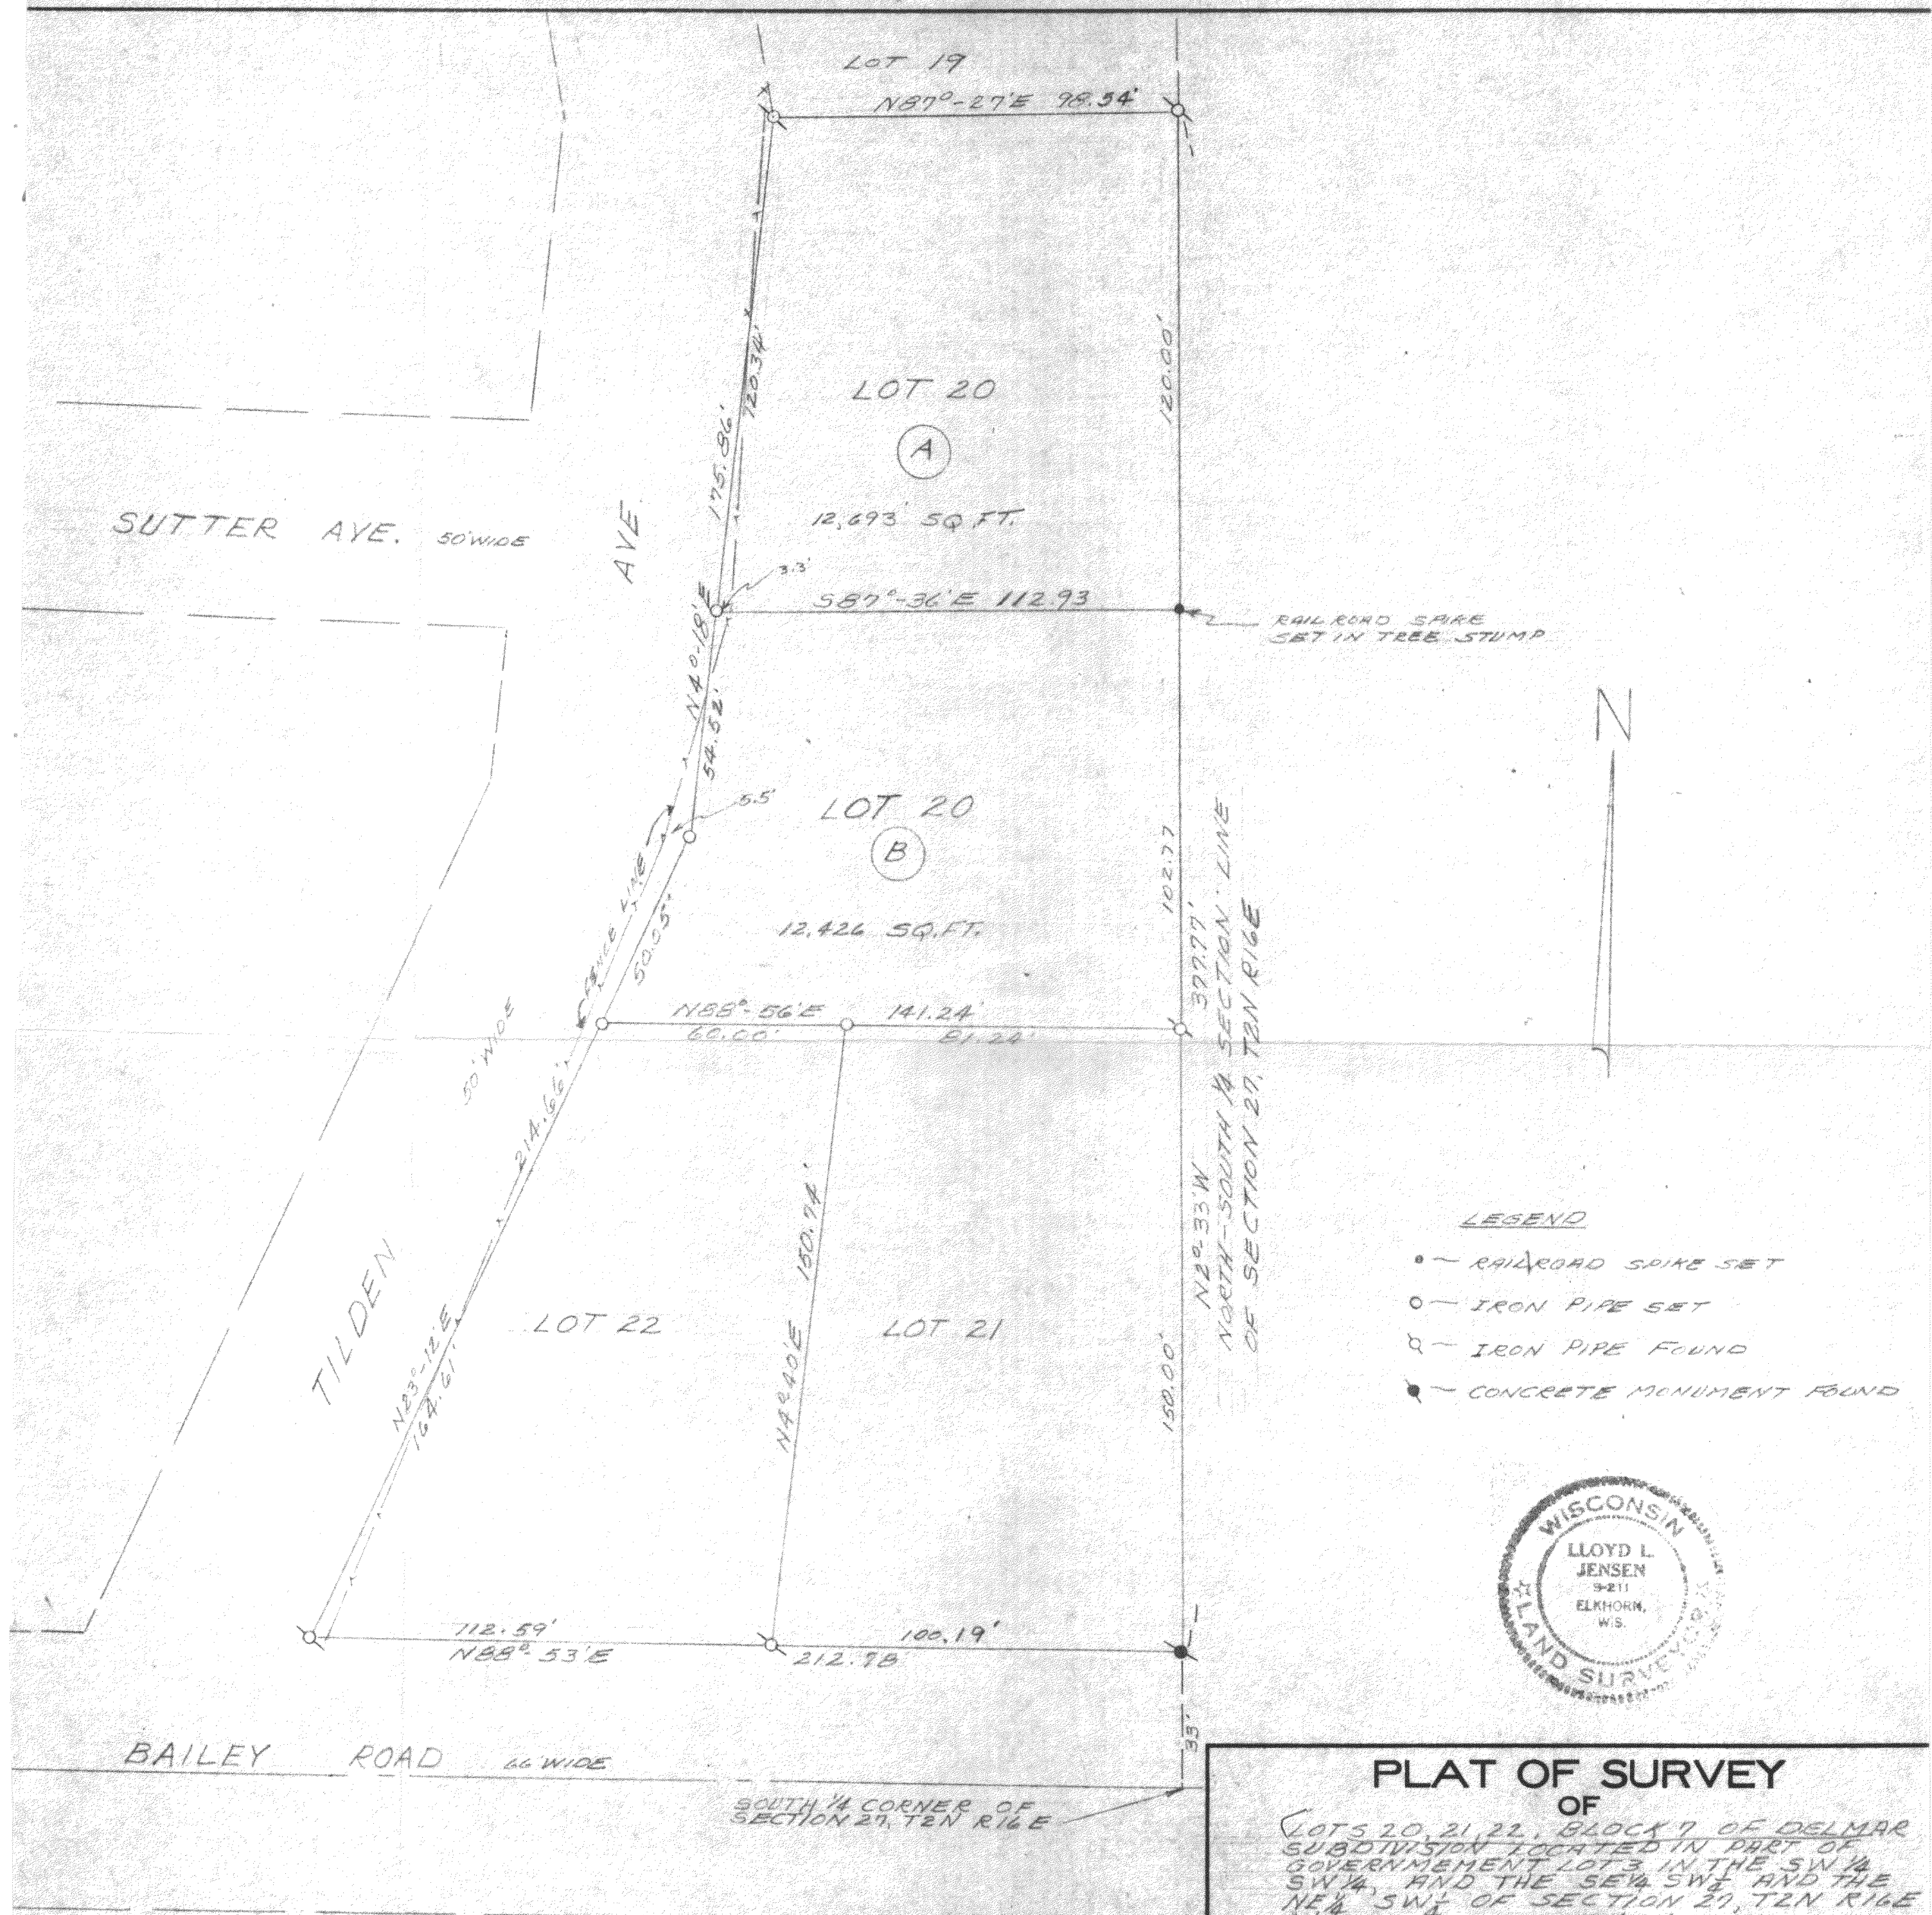

PLAT OF SURVEY OF

LOTS 20, 21, 22, BLOCK 7 OF DELMAR
SUBDIVISION LOCATED IN PART OF
GOVERNMENT LOT 3 IN THE SW 1/4
SW 1/4, AND THE SE 1/4 SW 1/4 AND THE
NE 1/4 SW 1/4 OF SECTION 20, T2N R16E
WALWORTH COUNTY WISCONSIN.

Lloyd L. Jensen
SURVEYOR