


ABELL
SURVEYING & MAPPING
 DELAVAN, WISCONSIN 53115
 414-726-6737

PLAT OF SURVEY OF

LOTS 8 AND 9, BLOCK 6 OF INLET OAKS SUBDIVISION NO. 4,
 LOCATED IN T2N,R16E, WALWORTH COUNTY, WISCONSIN.

ORDERED BY: RAY McCABE
 P.O. BOX 337A
 DELAVAN, WI. 53115

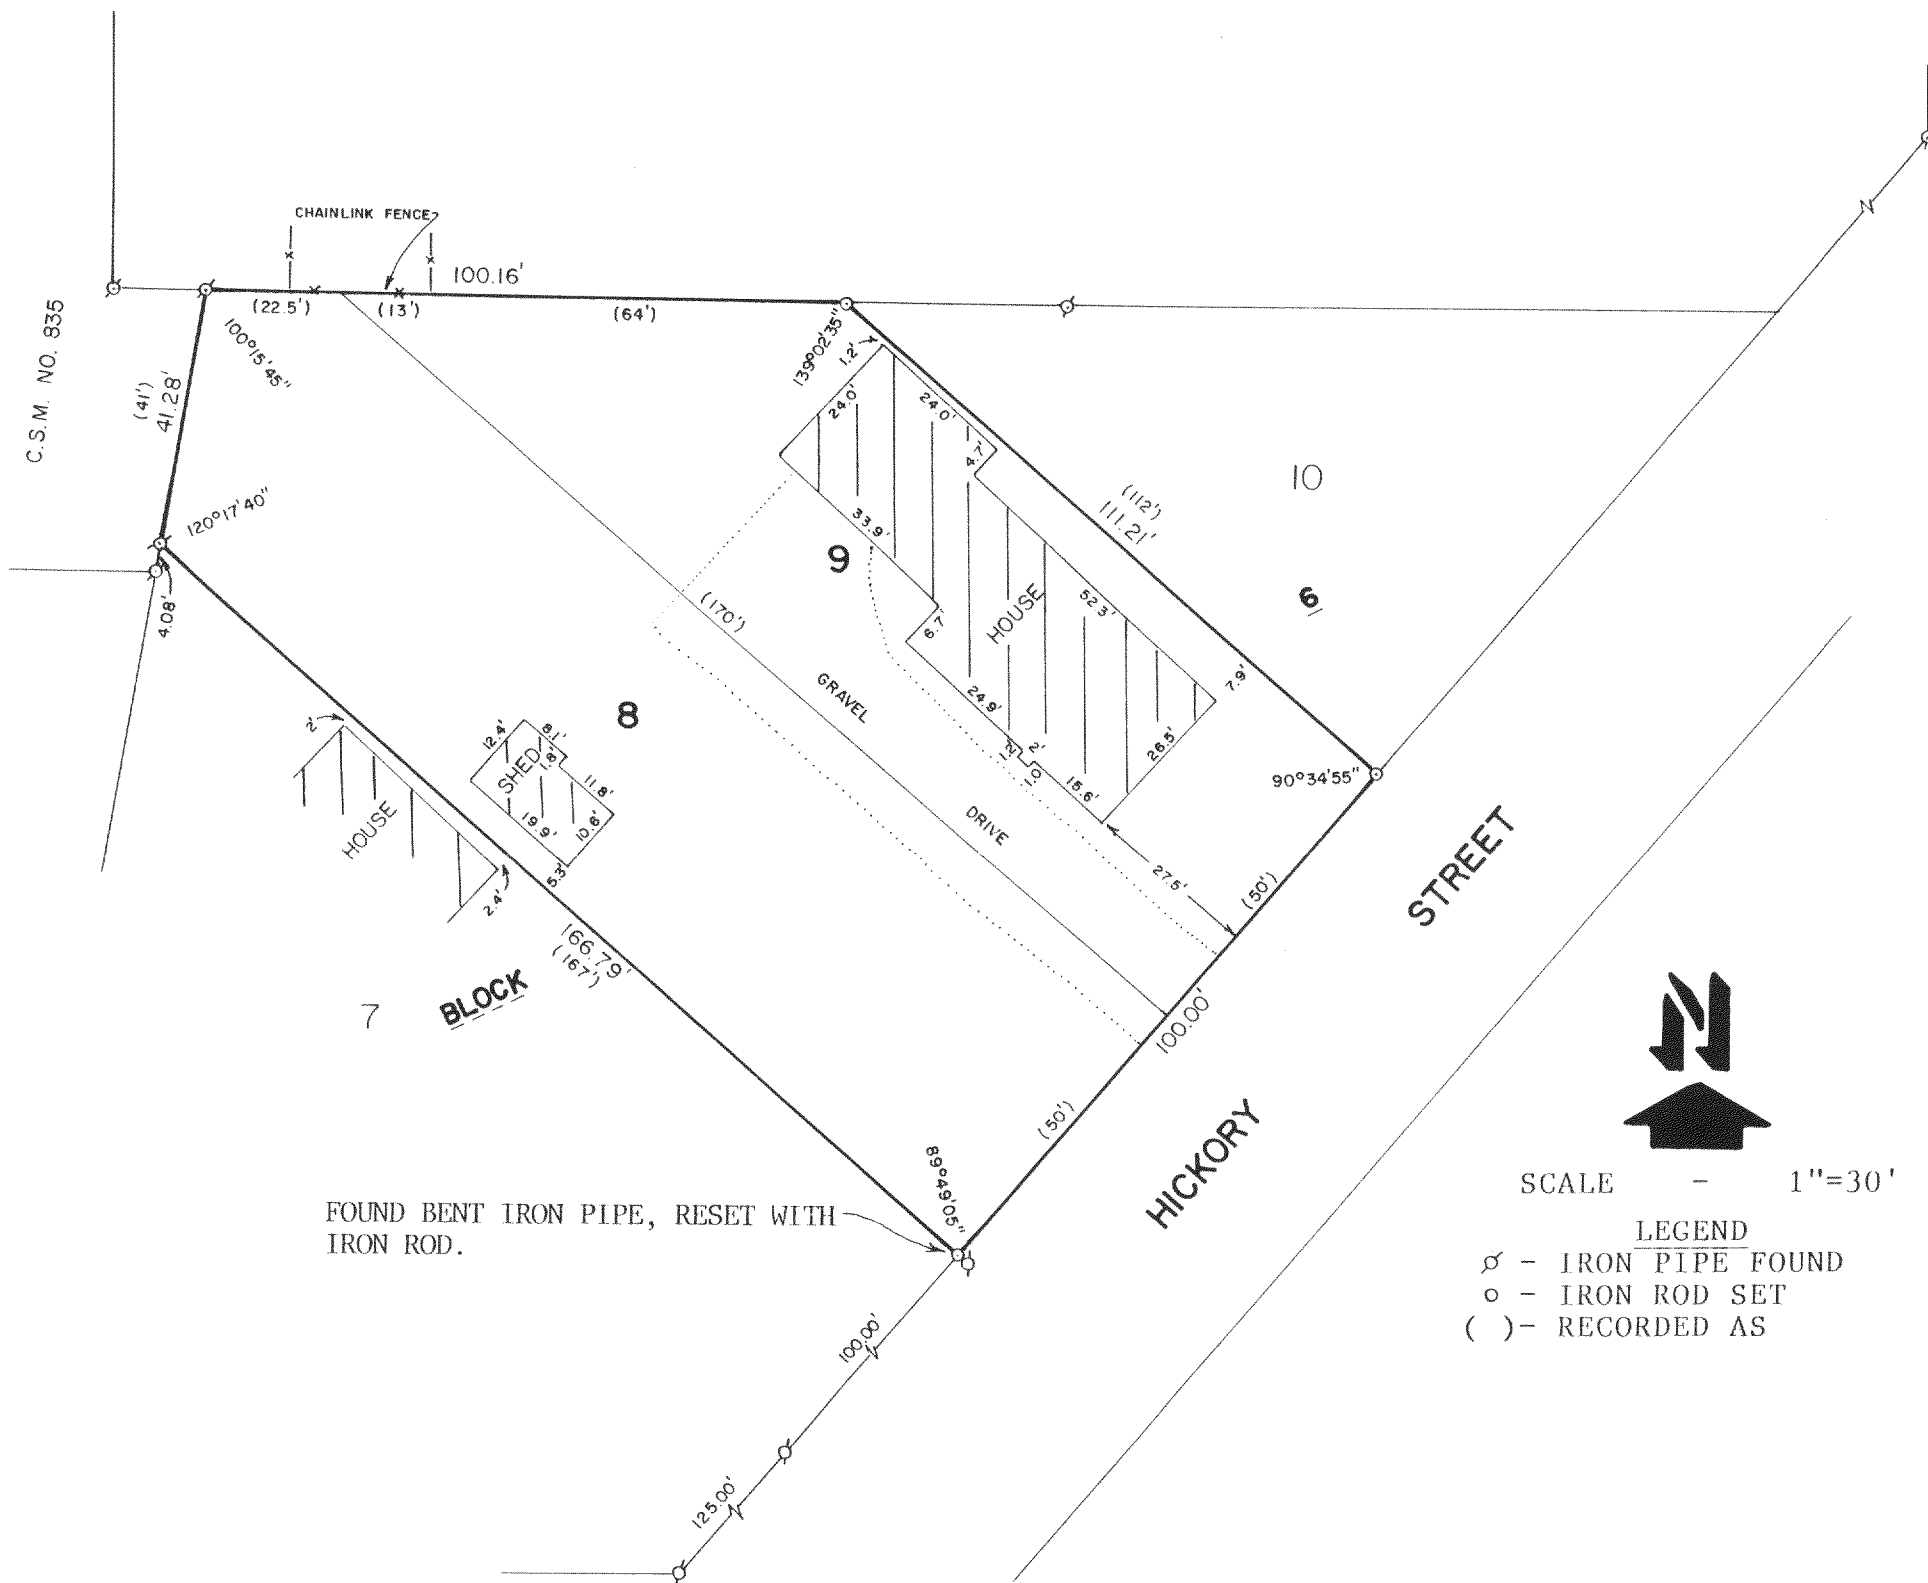


FOUND BENT IRON PIPE, RESET WITH
 IRON ROD.

SCALE - 1"=30'

LEGEND
 ♂ - IRON PIPE FOUND
 ○ - IRON ROD SET
 () - RECORDED AS

I HEREBY CERTIFY THAT I HAVE SURVEYED THE ABOVE DESCRIBED PROPERTY AND THAT THE ABOVE MAP IS A TRUE REPRESENTATION THEREOF AND SHOWS THE SIZE AND LOCATION OF THE PROPERTY, ITS EXTERIOR BOUNDARIES, THE LOCATION OF ALL VISIBLE STRUCTURES AND DIMENSIONS OF ALL PRINCIPAL BUILDINGS THEREON, BOUNDARY FENCES, APPARENT EASEMENTS, ROADWAYS AND VISIBLE ENCROACHMENTS, IF ANY, TO THE BEST OF MY KNOWLEDGE AND BELIEF.

THIS SURVEY IS MADE FOR THE USE OF THE PRESENT OWNERS OF THE PROPERTY, AND ALSO THOSE WHO PURCHASE, MORTGAGE, OR GUARANTEE THE TITLE THERETO WITHIN ONE (1) YEAR FROM DATE HEREOF.

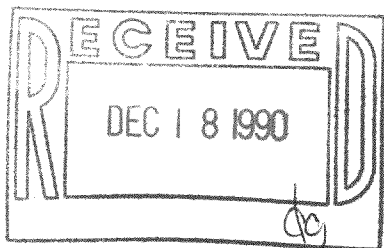

David F. Abell

DAVID F. ABELL
 WISCONSIN REGISTERED LAND SURVEYOR, S-1596

August 10, 1990

DATE JOB NUMBER - 90152

NOTE: THIS IS NOT A CERTIFIED COPY UNLESS SEALED.