


ABELL  
SURVEYING & MAPPING  
DELANAV. WISCONSIN 53115  
414-728-6737


WILLOW  
LANE  
20' WIDE

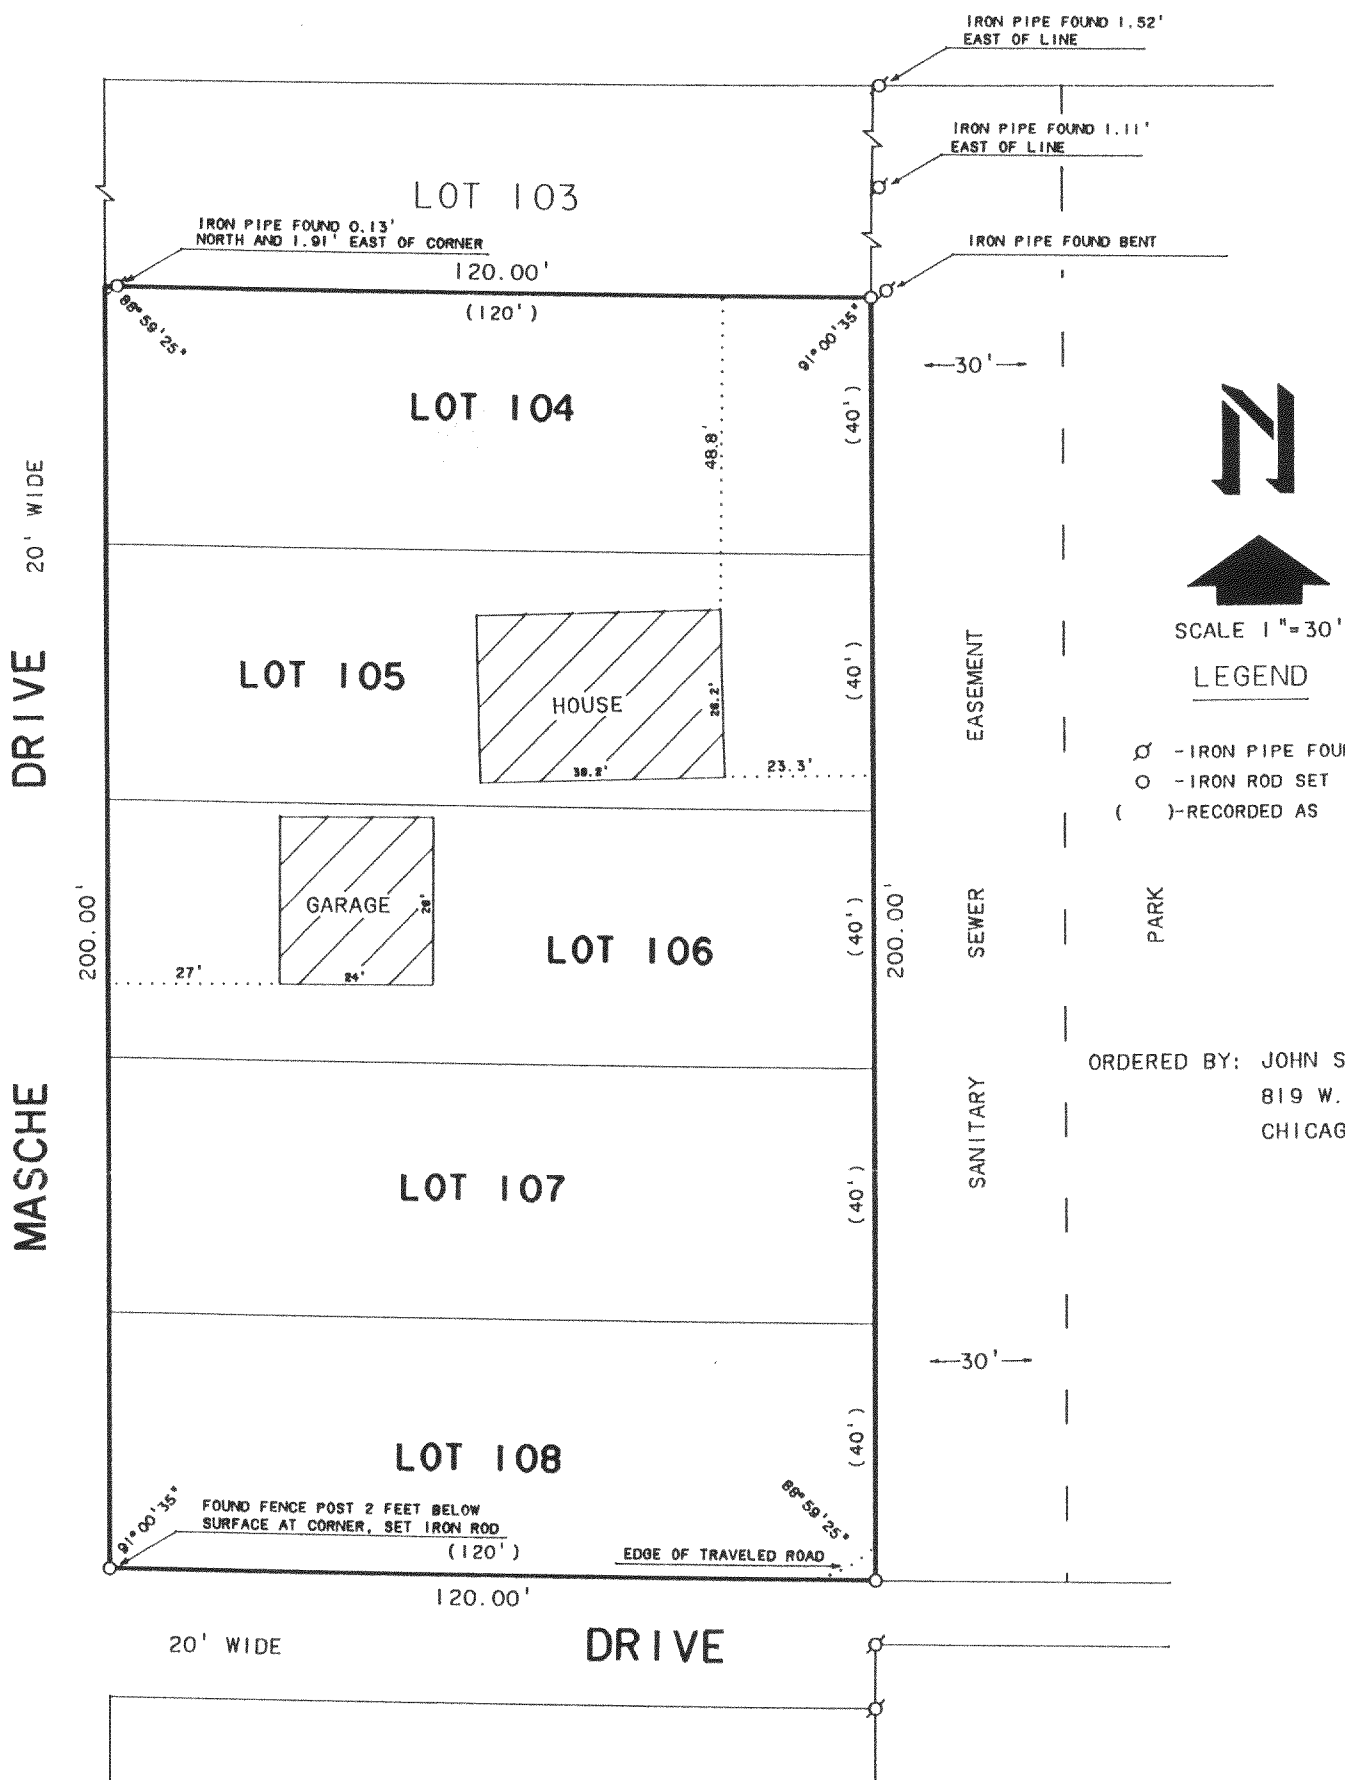

N  
SCALE 1"=30'  
LEGEND

Ø - IRON PIPE FOUND  
O - IRON ROD SET  
( ) - RECORDED AS

ORDERED BY: JOHN SHAFER  
819 W. MORSE AVE.  
CHICAGO, IL. 60626

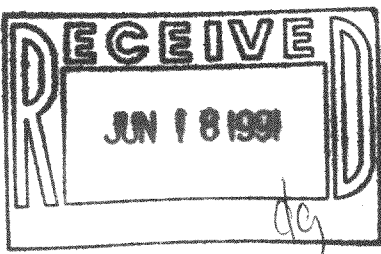

I, DAVID F. ABELL, DO HEREBY CERTIFY THAT I HAVE SURVEYED THE PROPERTY HEREON DESCRIBED ACCORDING TO THE OFFICAL RECORDS AND THAT THE PLAT HEREON IS A CORRECT REPRESENTATION OF THE PROPERTY LINES TO THE BEST OF MY KNOWLEDGE AND BELIEF  
*David F. Abell*  
DAVID F. ABELL  
WISCONSIN REGISTERED LAND SURVEYOR, S-1596

January 2, 1991  
DATE JOB NUMBER - 90179  
NOTE: THIS IS NOT A CERTIFIED COPY UNLESS SEALED.

FRA2 00004  
FRA2 00005  
FRA2 00006

216-1430