


○
→

88

83.70

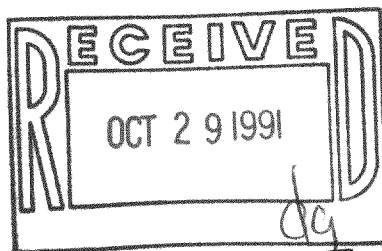

Note: This survey plat is not

and sealed in red ink.

Thomas P.A. Jensen R.L.S. 1084

Mapping date: AUGUST 28, 1991

Revisions: _____

Job reference number:

FR0C 00010

Well

Recorded as dimension

216-1460