
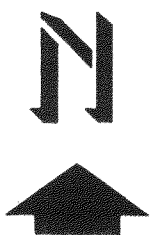


ABELL
SURVEYING & MAPPING
DELAVAN, WISCONSIN 53115
414-728-6737

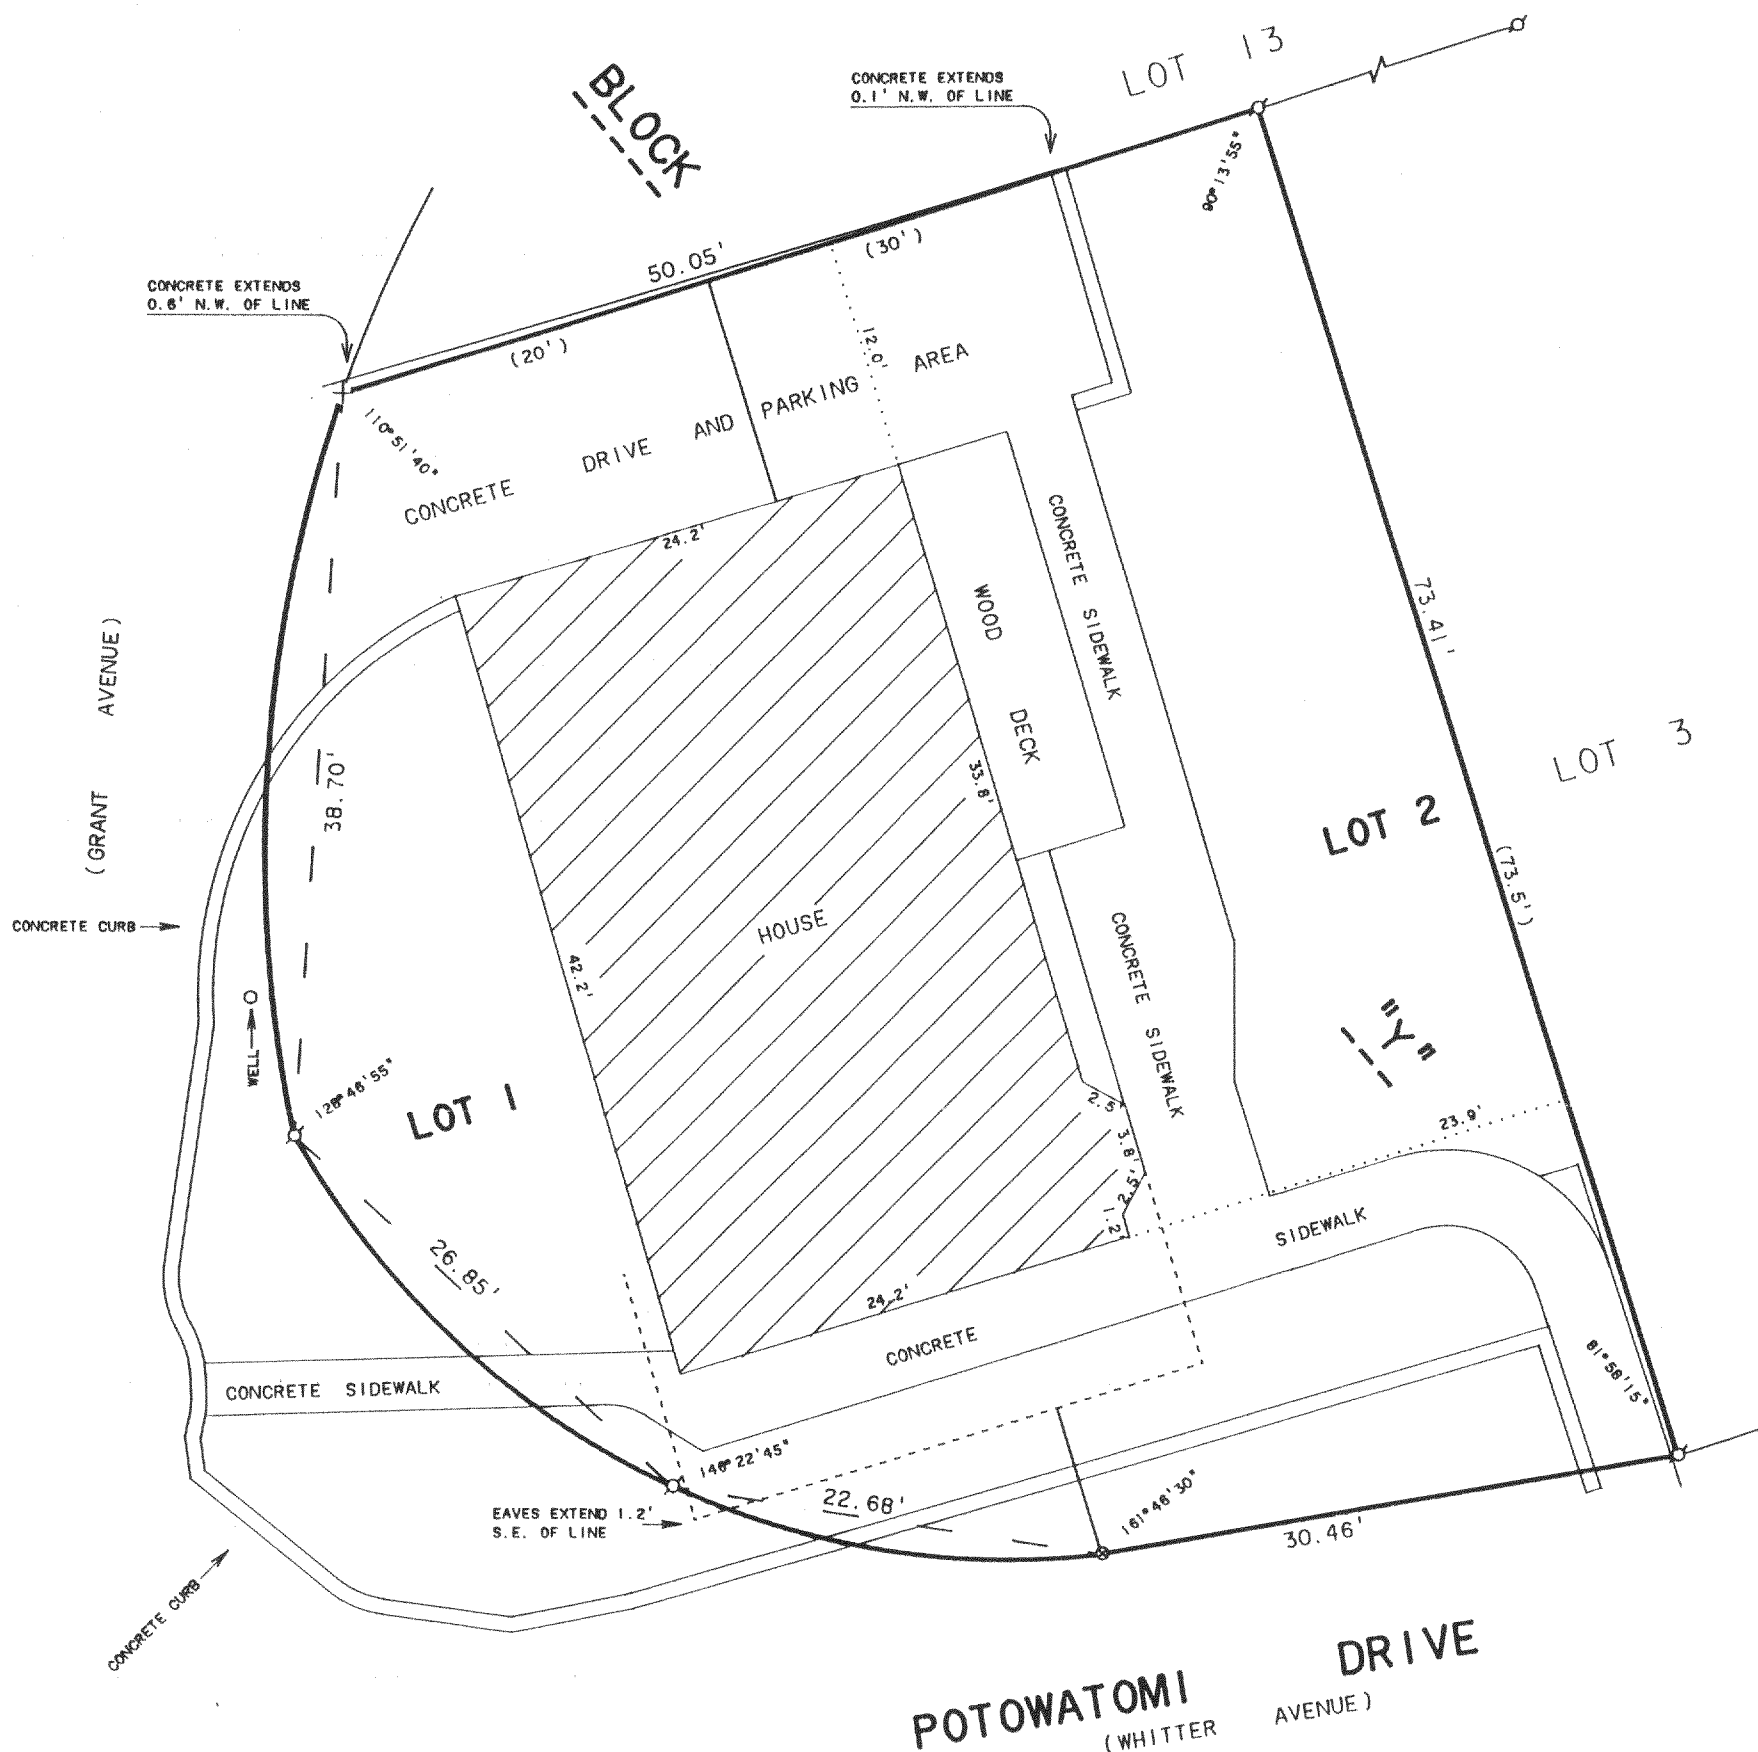

SCALE 1"=10'


LEGEND

- ⊙ - IRON PIPE FOUND
- + - CUT CROSS IN CONCRETE FOUND
- ⊗ - RAILROAD SPIKE SET
- () - RECORDED AS

ORDERED BY: STEBNITZ BUILDERS
P.O. BOX 526
DELAVAN, WI. 53115

PLAT OF SURVEY OF

LOTS 1 AND 2, BLOCK "Y", DELAVAN LAKE
ASSEMBLY GROUNDS, LOCATED IN T2N, R16E,
WALWORTH COUNTY, WISCONSIN.

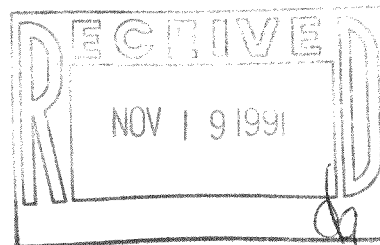

I, DAVID F. ABELL, DO HEREBY CERTIFY THAT I HAVE SURVEYED THE PROPERTY HEREON DESCRIBED ACCORDING TO THE OFFICIAL RECORDS AND THAT THE PLAT HEREON IS A CORRECT REPRESENTATION OF THE PROPERTY LINES TO THE BEST OF MY KNOWLEDGE AND BELIEF.

David F. Abell
DAVID F. ABELL

WISCONSIN REGISTERED LAND SURVEYOR, S-1596

August 21, 1991

DATE JOB NUMBER - 91171

NOTE: THIS IS NOT A CERTIFIED COPY UNLESS SEALED.