

ABELL

DELAVAN, WISCONSIN 53115


414-728-6737

LOT 15

LOT 53

PLAT OF SURVEY OF

LOT 52, LAKE DELAVAN HIGHLANDS, LOCATED
IN T2N, R16E, WALWORTH COUNTY, WISCONSIN.

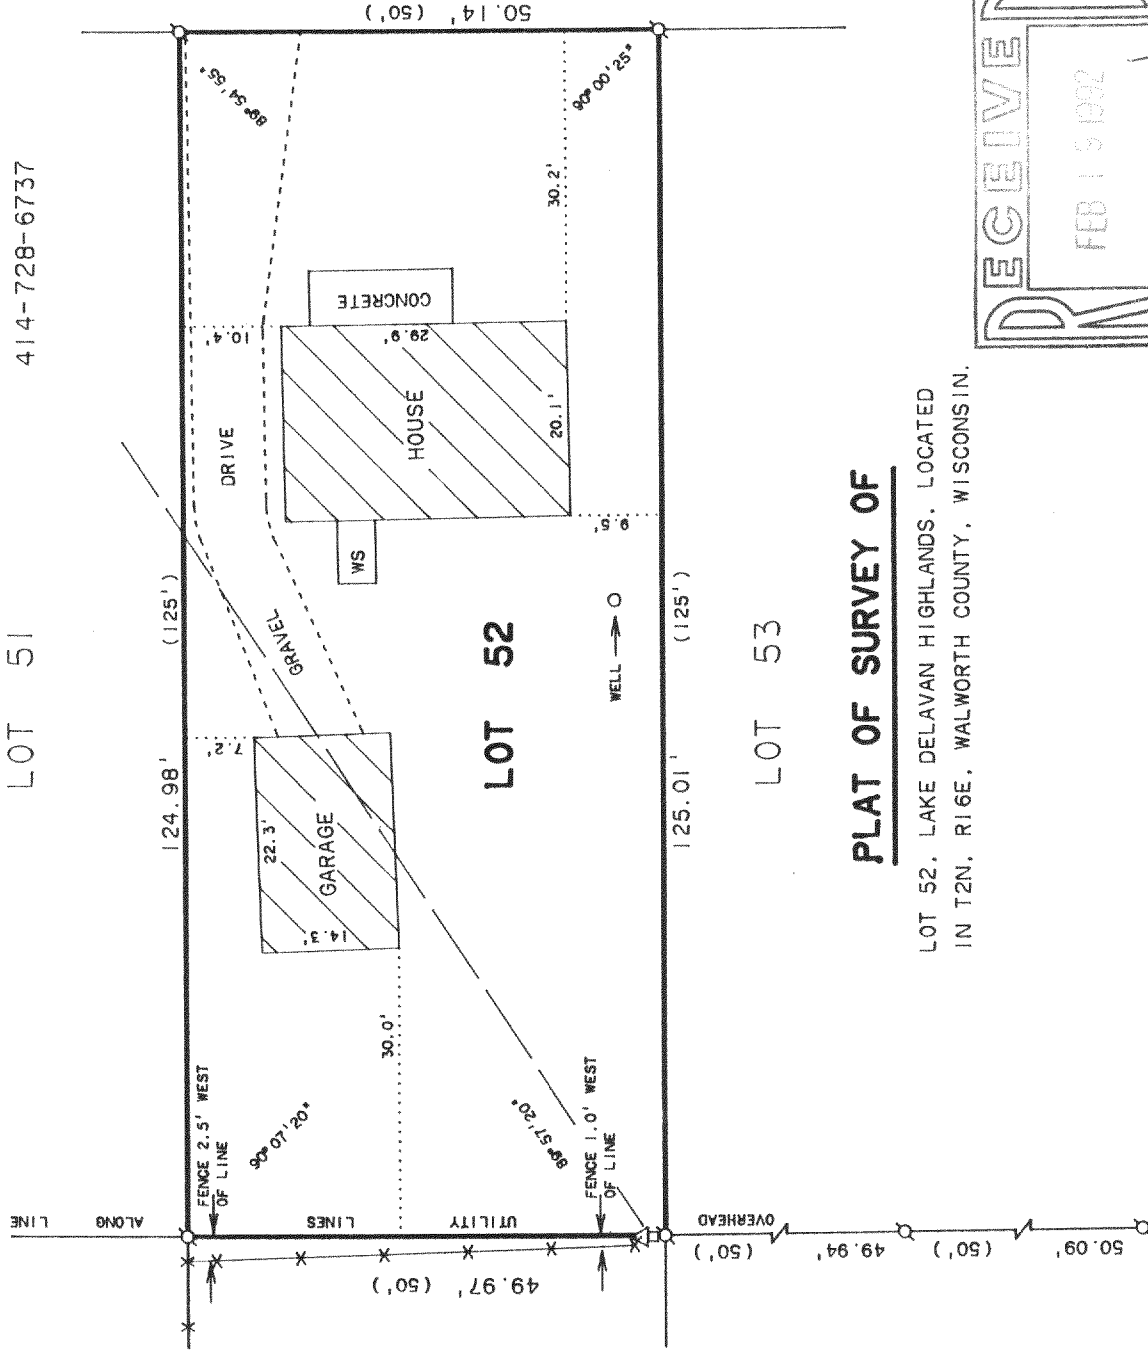

SCALE 1"=20'

LEGEND

- Ø - IRON PIPE FOUND
 □ - UTILITY PED.
 Δ - UTILITY POLE
 WS - WOOD STOOP
 * - WOOD FENCE
 --- - OVERHEAD UTILITY LINES
 () - RECORDED AS

ORDERED BY: PROFESSIONAL REALTY
706 E. GENEVA ST.
DELAVER, WI. 53115

I HEREBY CERTIFY THAT I HAVE SURVEYED THE ABOVE DESCRIBED PROPERTY AND THAT THE ABOVE MAP IS A TRUE REPRESENTATION THEREOF AND SHOWS THE SIZE AND LOCATION OF THE PROPERTY, ITS EXTERIOR BOUNDARIES, THE LOCATION OF ALL VISIBLE STRUCTURES AND DIMENSIONS OF ALL PRINCIPAL BUILDINGS THEREON, BOUNDARY FENCES, APPARENT EASEMENTS, ROADWAYS AND VISIBLE ENCROACHMENTS, IF ANY, TO THE BEST OF MY KNOWLEDGE AND BELIEF.


THIS SURVEY IS MADE FOR THE USE OF THE PRESENT OWNERS OF THE PROPERTY, AND ALSO THOSE WHO PURCHASE, MORTGAGE, OR GUARANTEE THE TITLE THERETO WITHIN ONE (1) YEAR FROM DATE HEREOF.

FROM DATE HEREOF.

DAVID F. ABELL
WISCONSIN REGISTERED LAND SURVEYOR. 9-1596

November 13, 1991

DATE _____ JOB NUMBER - 91250
NOTE: THIS IS NOT A CERTIFIED COPY UNLESS SEALED.

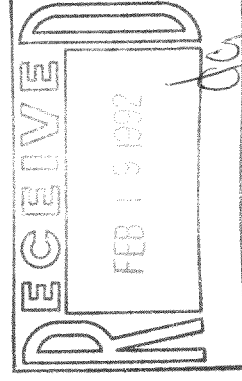

5-6-8

5-1-54