


DUNHAM SURVEYING, S.C.
SURVEYING & SUBDIVIDING
DELAVER, WISCONSIN 53115

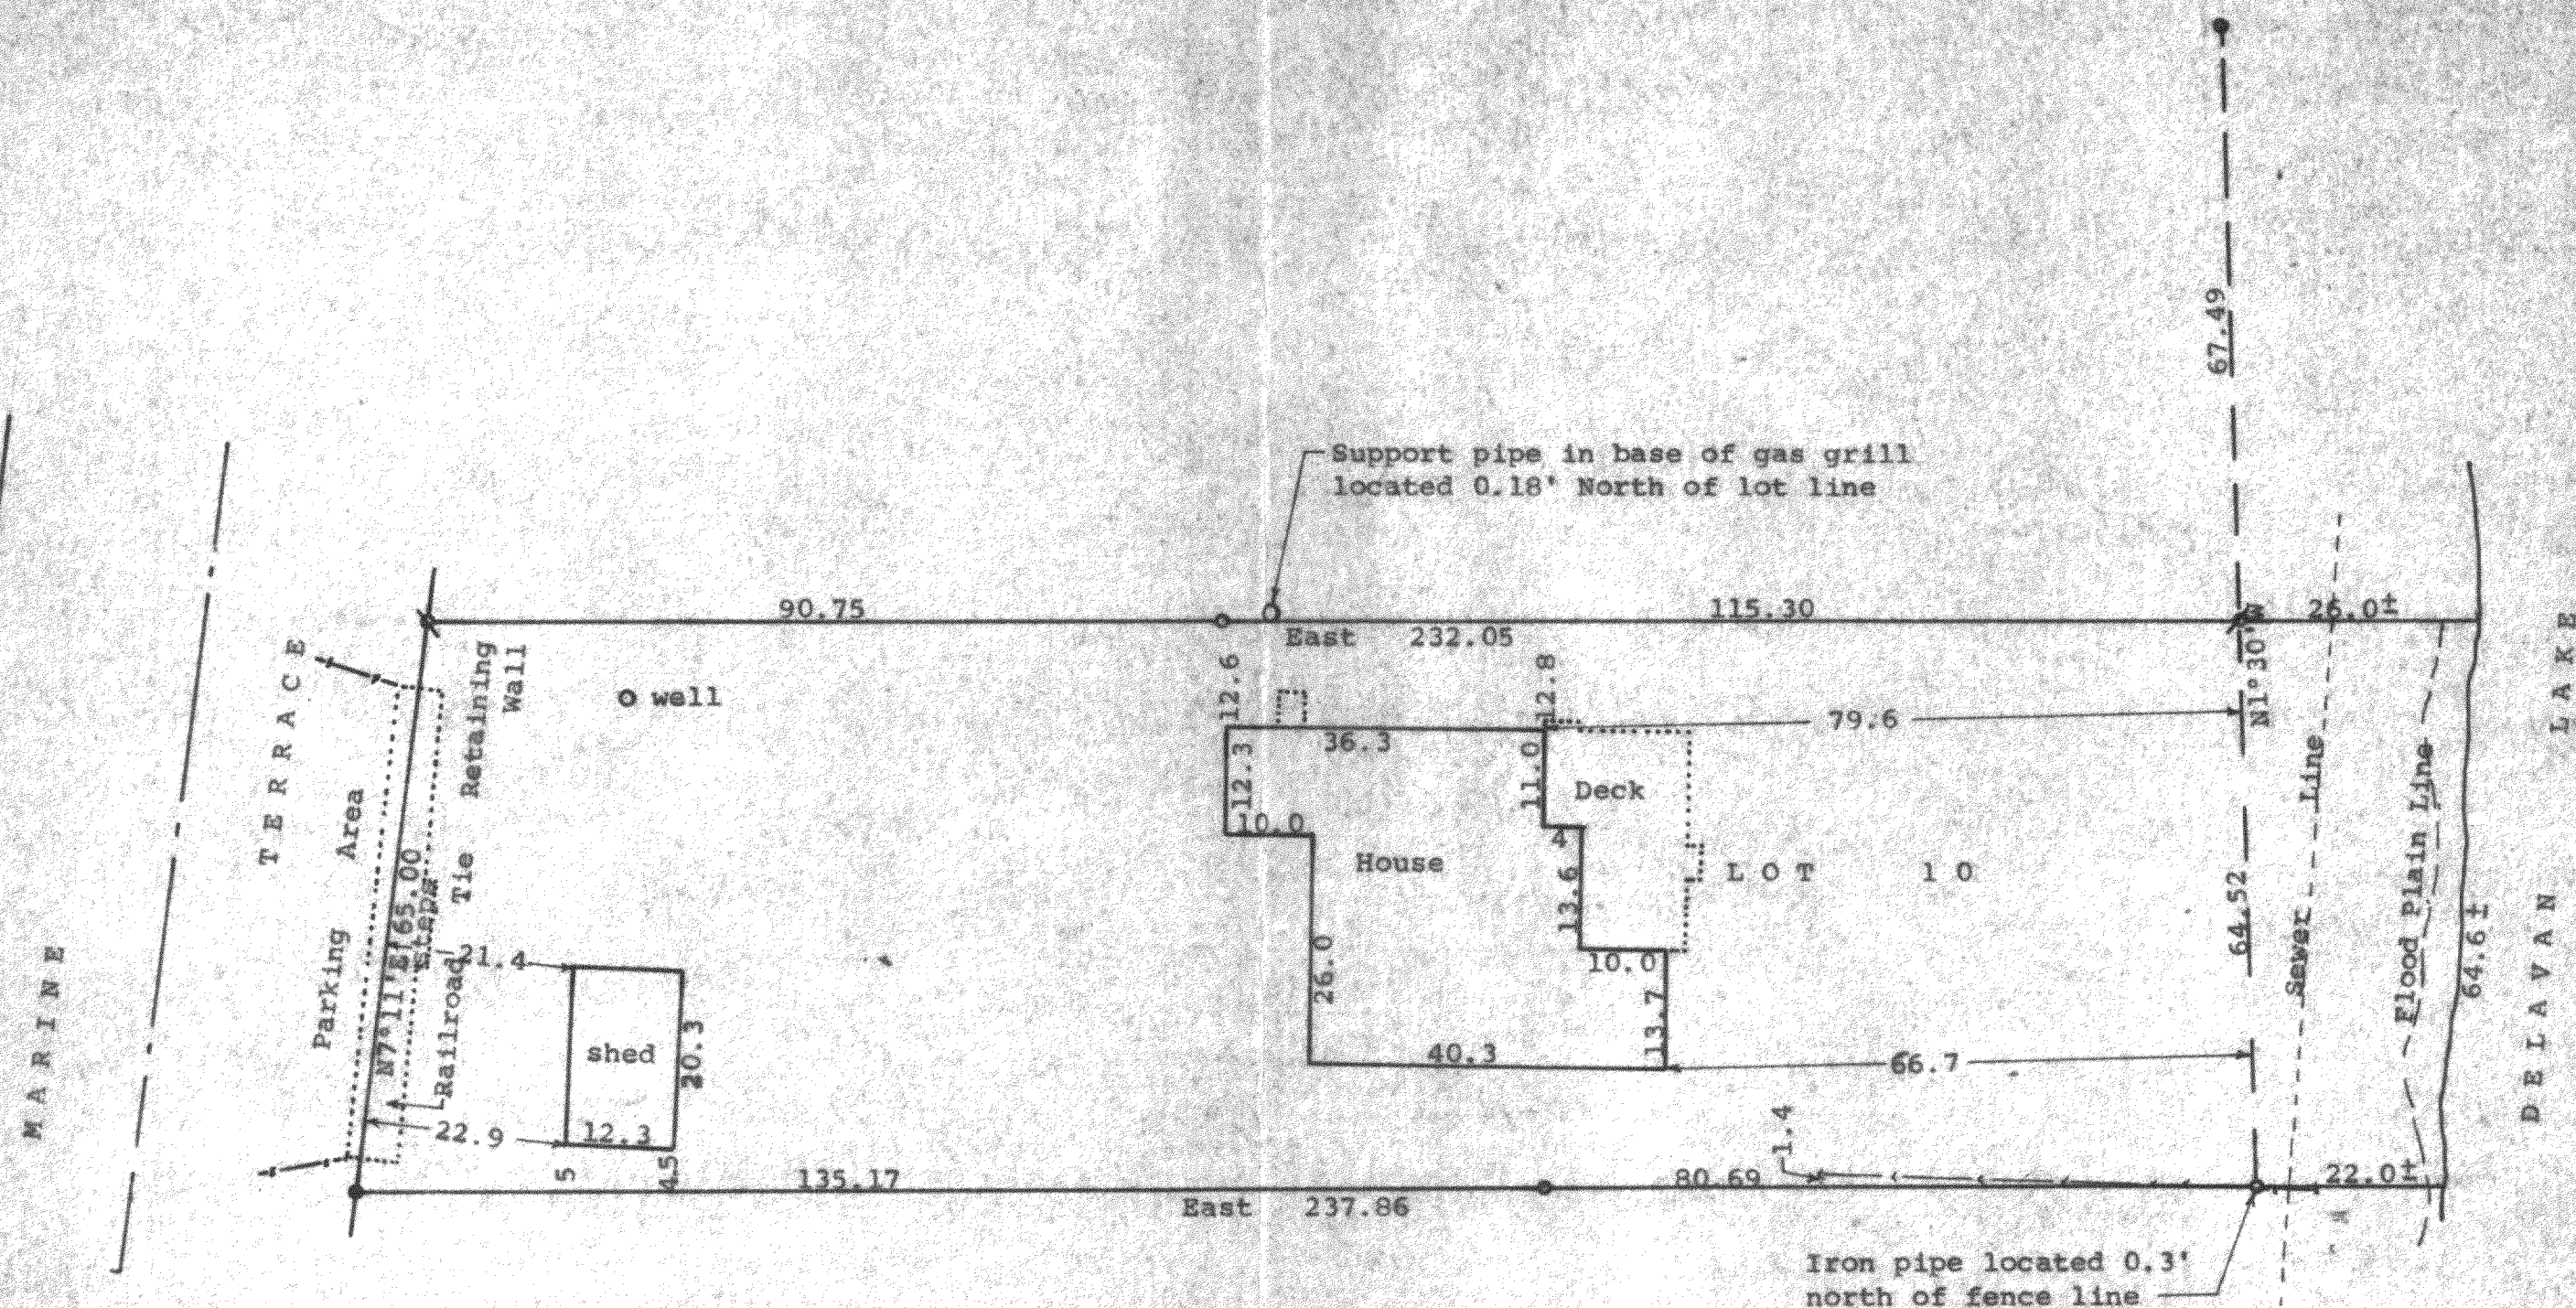

Scale - 1" = 20'

● = Concrete Monument Found
○ = 1" bent Iron Pipe found
0.8' below ground. Pulled
and reset

○ = 3/4" X 24" Iron Pipe Set

Bearings are those given on the recorded
plat of Woodlawn Bay Community

--- = Fence Line

Survey ordered by:

Century 21, Skandia Realty

312 South 7th Street

Delavan, WI 53115

○ = 3/4" Iron Pipe Found

STATE OF WISCONSIN) SS
COUNTY OF WALWORTH)

I, George T. Dunham, Surveyor, certify that I have surveyed the
property described as follows:

Lot 10 in Block 1, of Woodlawn Bay Community, a subdivision
located in the Southwest 1/4 of the Southeast 1/4 of Section
21 and the Northwest 1/4 of the Northeast 1/4 of Section 28,
all in T 2 N, R 16 E, Walworth County, Wisconsin, subject
to easements of record,

and that the plat shown hereon is a correct representation thereof and shows
the size and location of the property, its exterior boundaries, the location
of all visible structures and dimensions of all principal buildings thereon,
boundary fences, apparent easements, roadways and visible encroachments, if
any, and that I have surveyed the property hereon described, according to the
official records, to the best of my knowledge and belief.

February 19, 1991

George T. Dunham
George T. Dunham, Surveyor

