


DUNHAM SURVEYING, S.C.
SURVEYING & SUBDIVIDING
DELAVER, WISCONSIN 53115

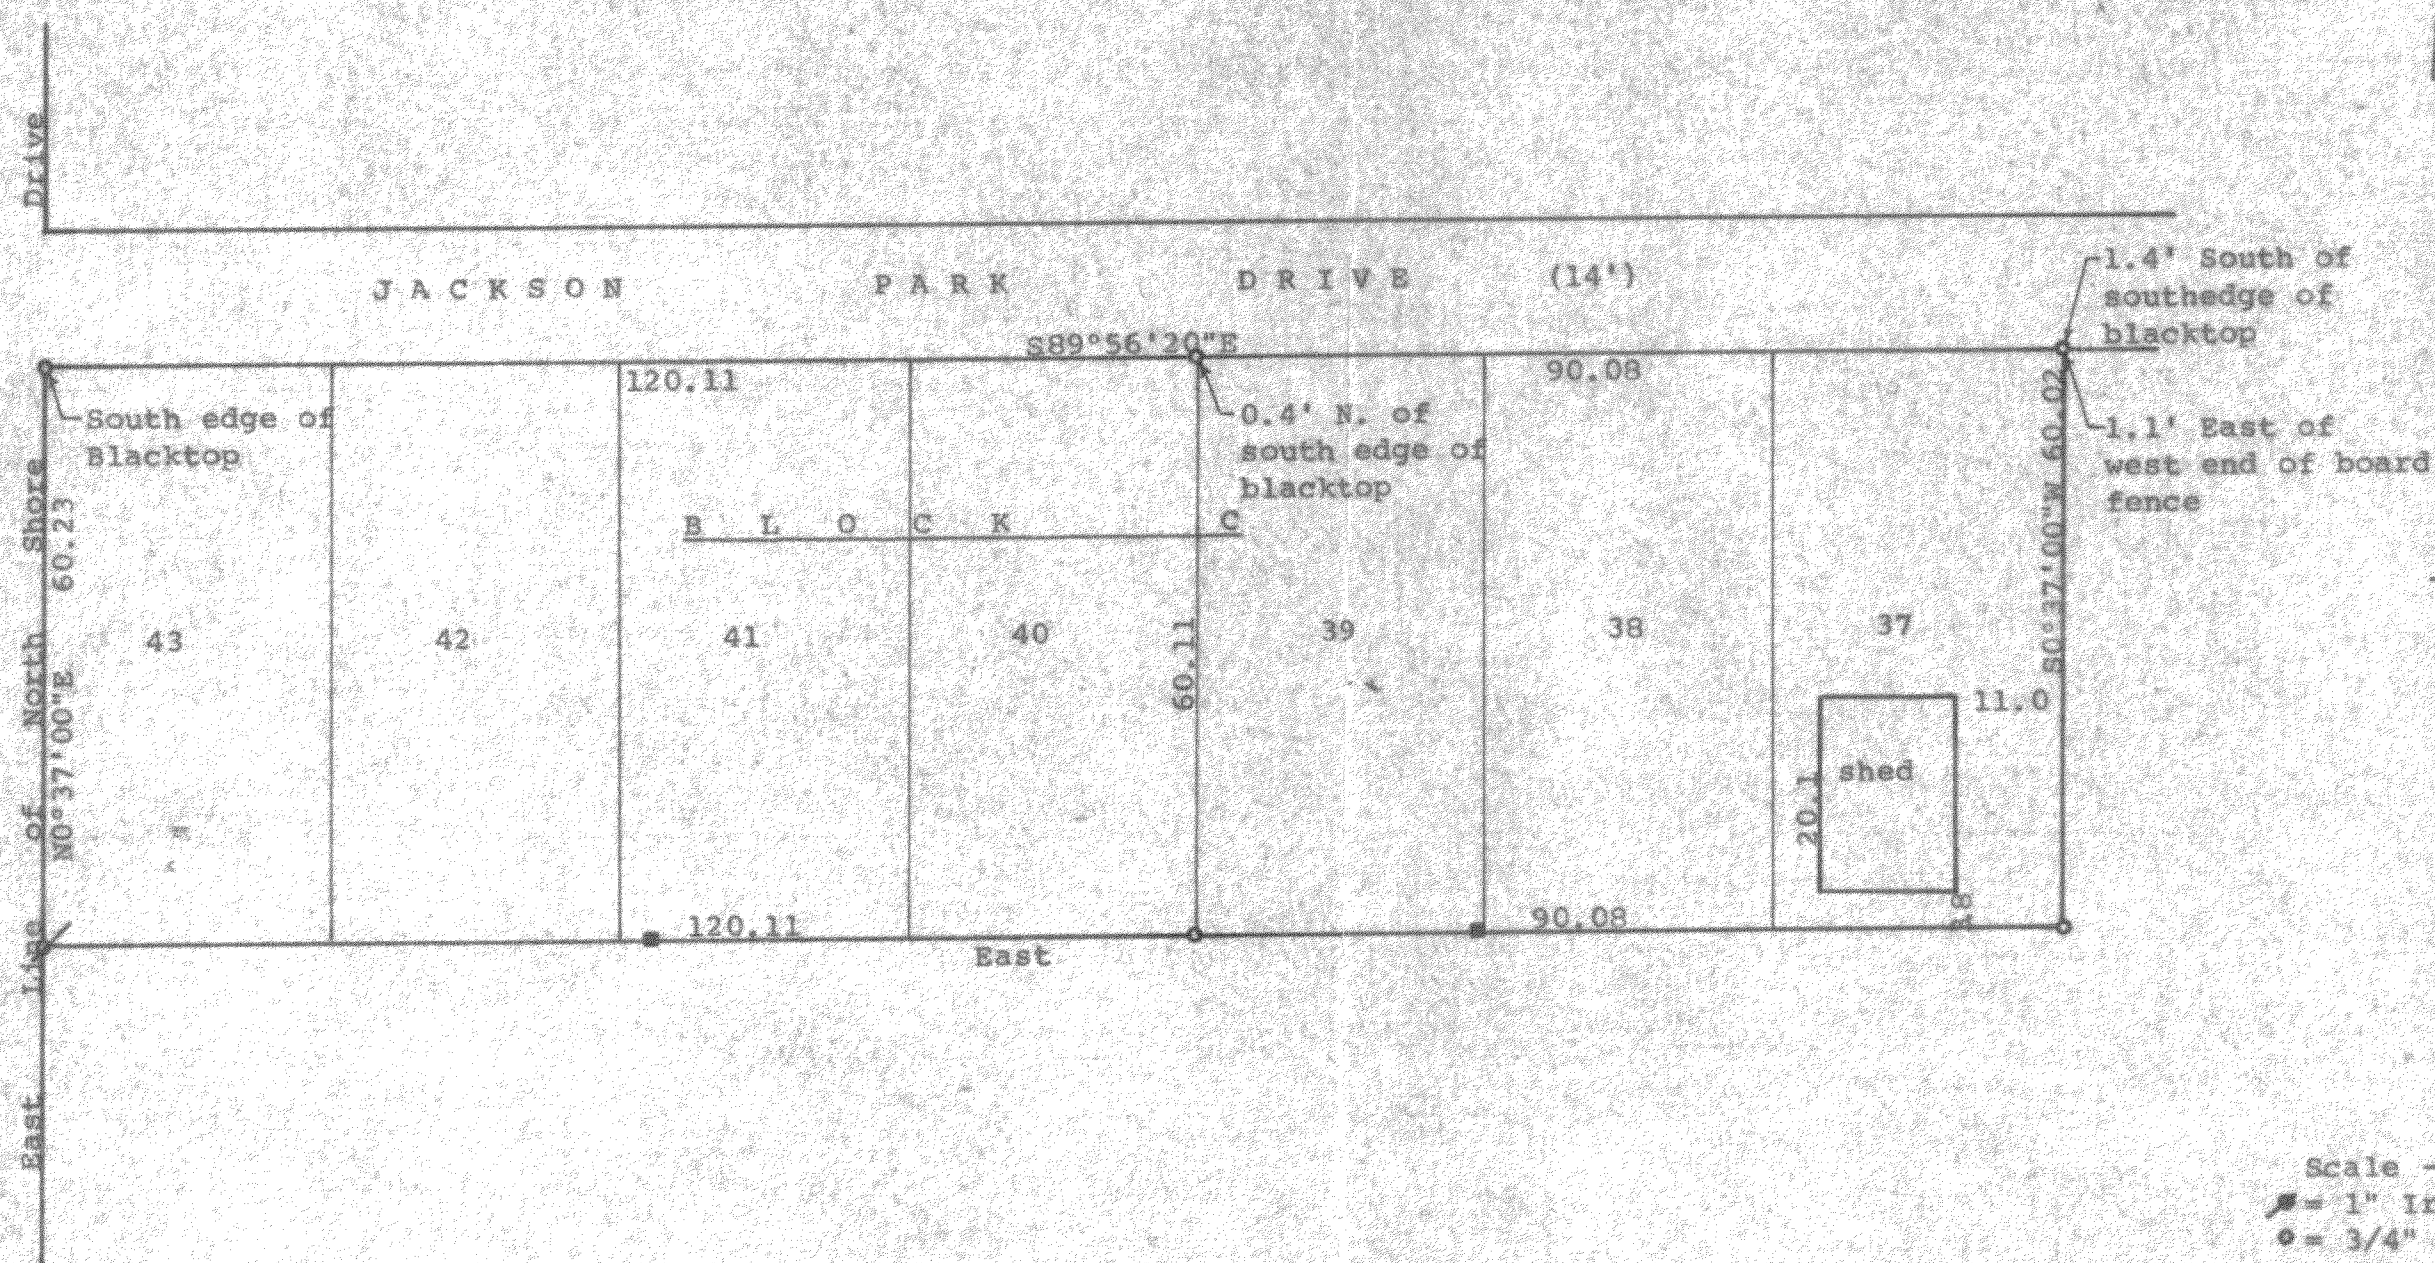

Scale - 1" = 20'
 ■ = 1" Iron Pipe Found
 ● = 3/4" Iron Pipe Found
 ■ = Telephone Box
 Bearings referenced to the South Line
 of Block C of Jackson's Subdivision
 with the assumed bearing of East
 Survey ordered by:
 Century 21, Skandia Realty
 312 South 7th Street
 Delaver, WI 53115

STATE OF WISCONSIN)
COUNTY OF WALWORTH) ss

I, George T. Dunham, Surveyor, certify that I have surveyed the property described as follows:

Lots 37 to 43 inclusive in Block C of Jackson's Subdivision located in Section 21, T 2 N, R 16 E, Walworth County, Wisconsin, and that the plat shown hereon is a correct representation thereof and shows the size and location of the property, its exterior boundaries, the location of all visible structures and dimensions of all principal buildings thereon, boundary fences, apparent easements, roadways and visible encroachments, if any, and that I have surveyed the property hereon described, according to the official records, to the best of my knowledge and belief.
February 7, 1991

George T. Dunham
George T. Dunham, Surveyor

