


ABELL SURVEYING & MAPPING

DELAN, WISCONSIN 53115

414-728-6737

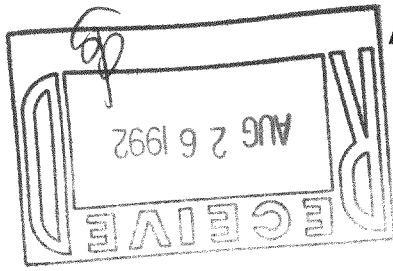


SCALE 1"=20'

LEGEND

- ⊗ - IRON PIPE FOUND
- WOOD FENCE
- SW - SIDEWALK
- () - RECORDED AS

ORDERED BY: RAY McCABE
4218 C.T.H. "O"
DELAN, WI. 53115

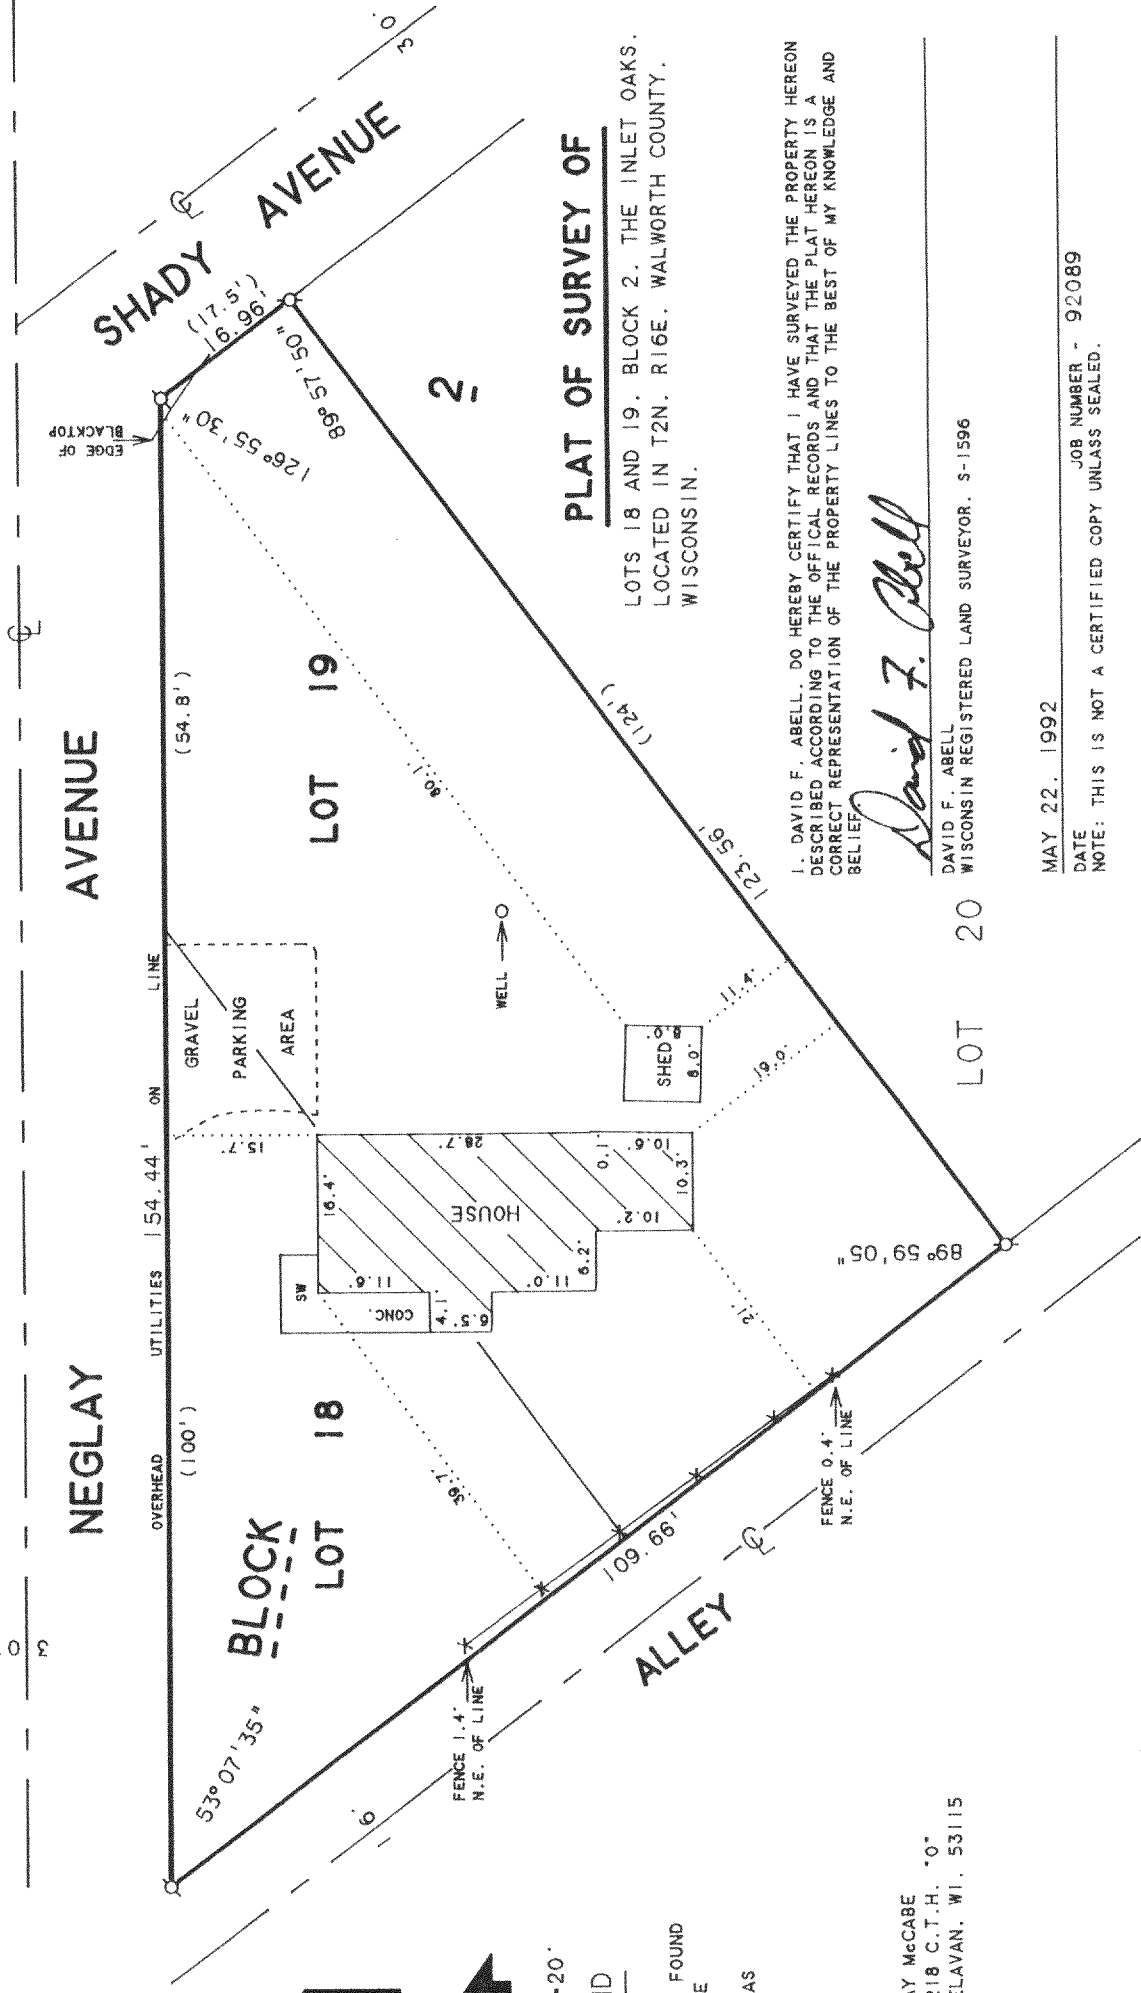

FIN-17A

216-1642