



ABELL
SURVEYING & MAPPING
DELAVAN, WISCONSIN 53115
414-728-6737

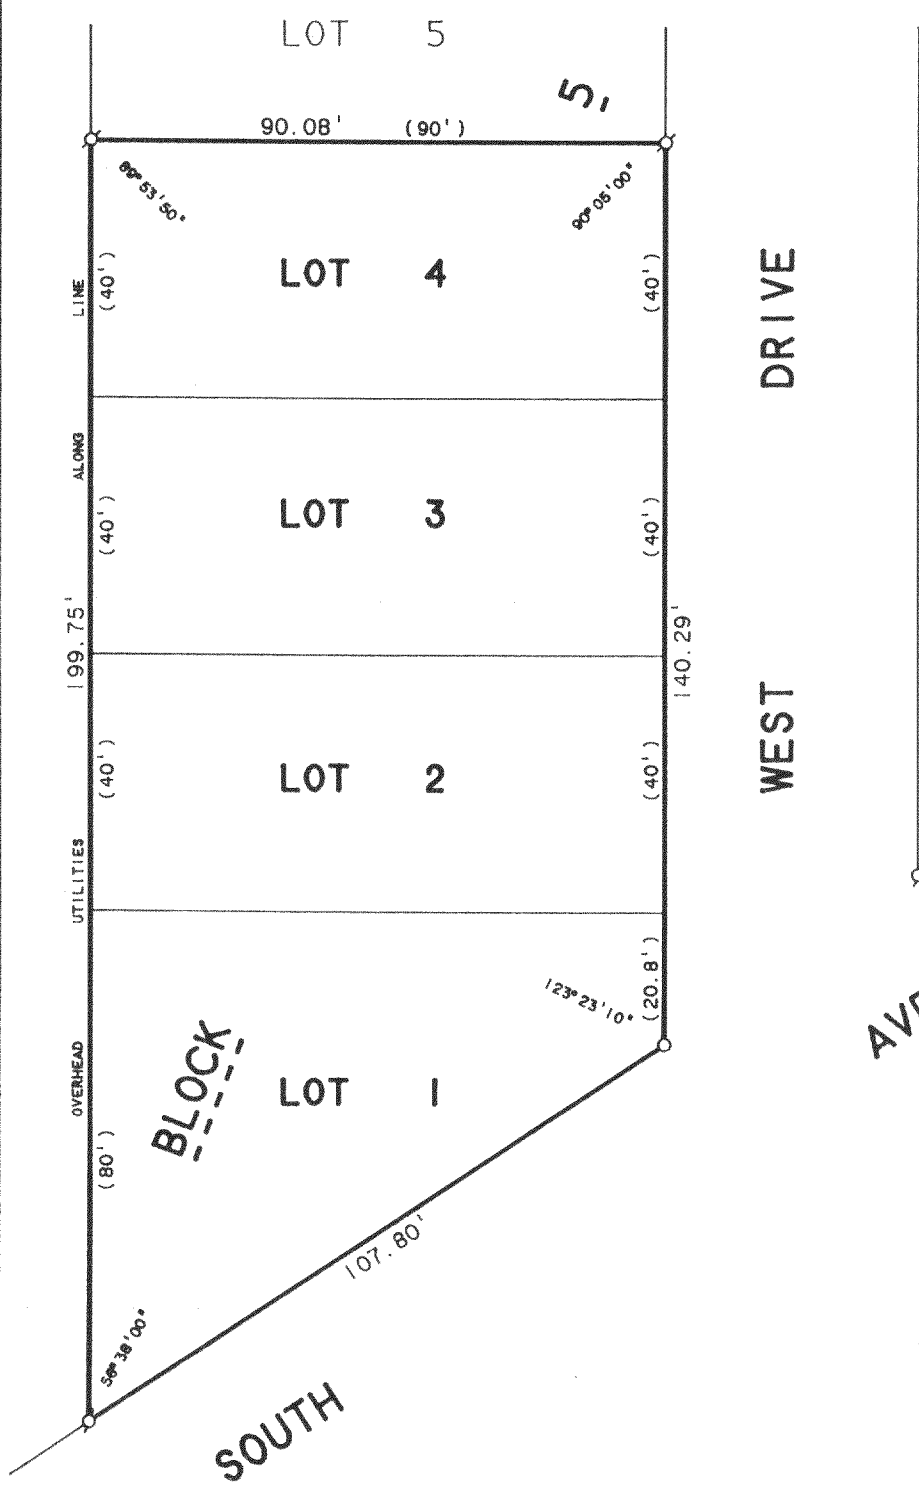

SCALE 1"=30'

LEGEND

- Ø - IRON PIPE FOUND
- O - IRON PIPE SET
- () - RECORDED AS

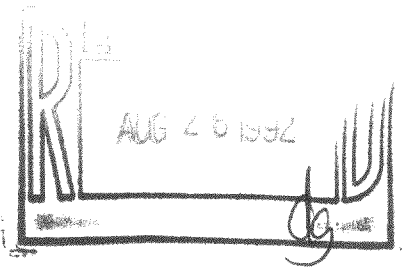

PLAT OF SURVEY OF

LOTS 1 - 4, BLOCK 5, SOUTH SHORE MANOR, LOCATED
IN T2N, R16E, WALWORTH COUNTY, WISCONSIN.

ORDERED BY: STEBNITZ BUILDERS
P.O. BOX 526
DELAVAN, WI 53115

I, DAVID F. ABELL, DO HEREBY CERTIFY THAT I HAVE SURVEYED THE PROPERTY HEREON DESCRIBED ACCORDING TO THE OFFICAL RECORDS AND THAT THE PLAT HEREON IS A CORRECT REPRESENTATION OF THE PROPERTY LINES TO THE BEST OF MY KNOWLEDGE AND BELIEF.
David F. Abell
DAVID F. ABELL
WISCONSIN REGISTERED LAND SURVEYOR, S-1596

MAY 27, 1992

DATE JOB NUMBER - 92085
NOTE: THIS IS NOT A CERTIFIED COPY UNLESS SEALED.

216-1652

FSS-68