


PLAT OF SURVEY  
-OF-

LOT 1, CERTIFIED SURVEY MAP No. 2028, being located in the Northwest 1/4 of the Northwest 1/4 of Section 28, Township 2 North, Range 16 East in the Township of Delavan, Walworth County, Wisconsin.


Proposed house was staked on actual corners with 3 foot control on the longest house line. The Contractor will be responsible to field verify all stakes for location and dimension prior to construction. If any discrepancies should arise, notify this office at once.

Survey For: American Dream Builders

Proposed Address: \_\_\_\_\_ Sage Road  
Proposed Yd. Gr.: \_\_\_\_\_  
Proposed Fn. Fl.: \_\_\_\_\_


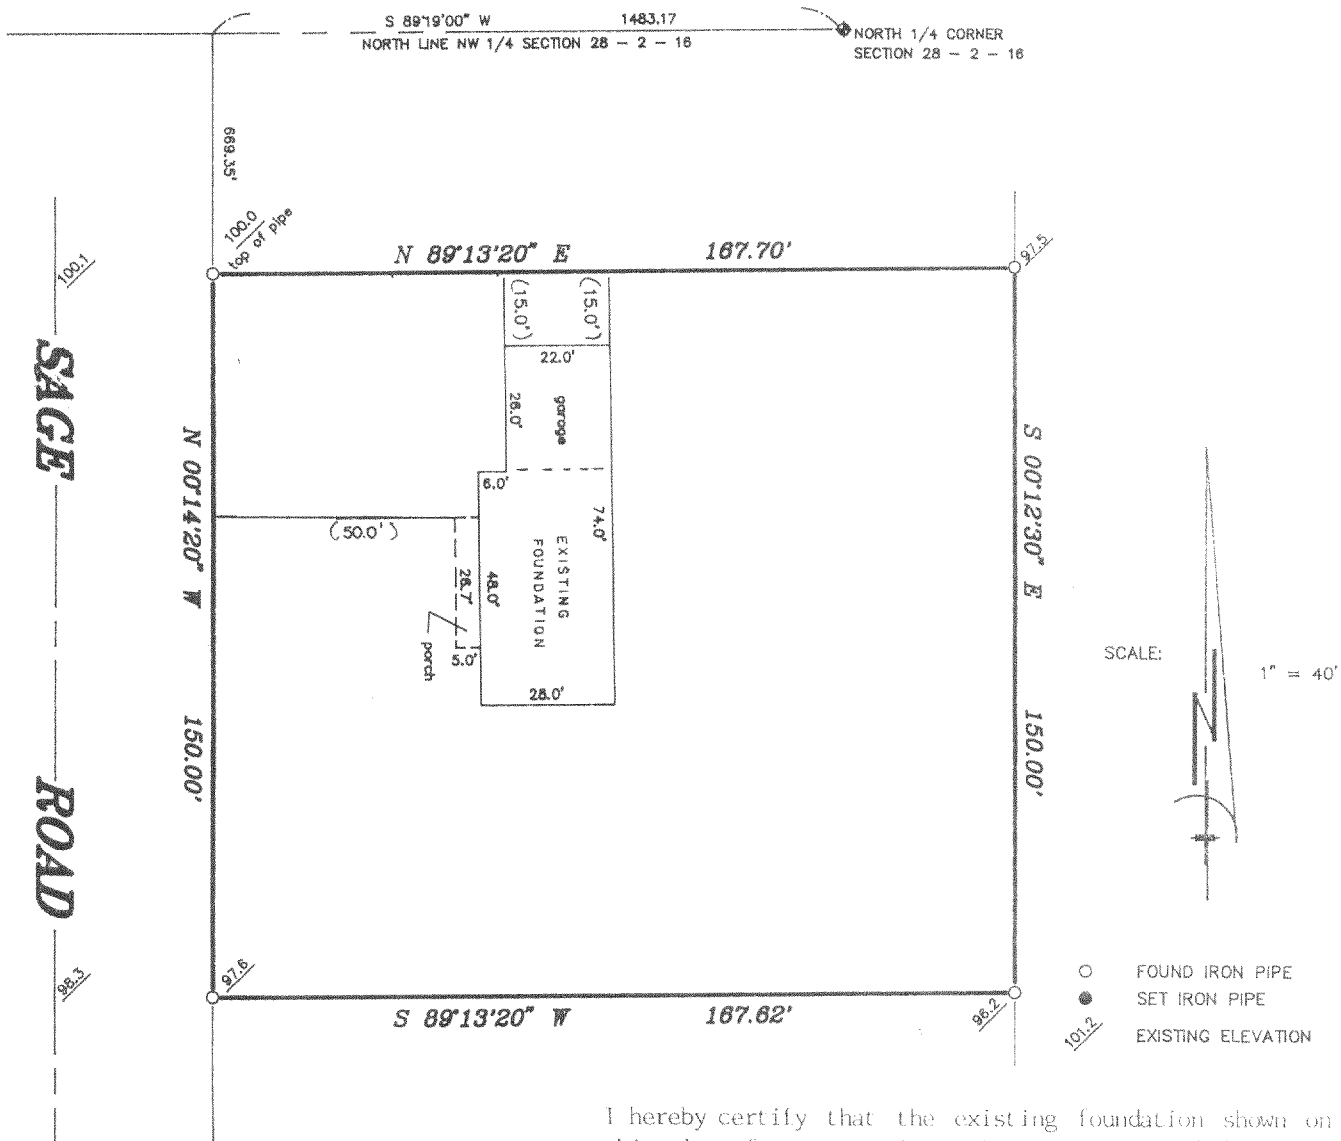


I hereby certify that the existing foundation shown on this plat of survey is located as shown thus ( ), dated this 4th day of May, 1992.

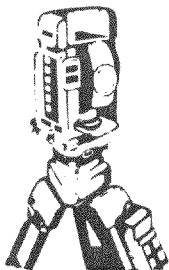

**B.W. SURVEYING**  
Land Surveys  
Mapping And Planning  
35117 Academy Road  
Burlington, Wisconsin 53105  
(414) 534-4109

*Robert J. Wetzel*  
Robert J. Wetzel S-1778

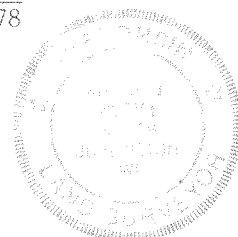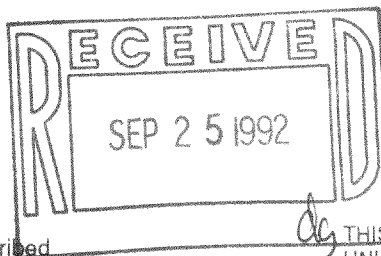

"I hereby certify that I have surveyed the above described property and that the above map is a true representation thereof and shows the size and location of the property, its exterior boundaries, the location of all visible structures and dimensions of all principal buildings thereon, boundary fences, apparent easements, roadways and encroachments, if any.

"This survey is made for the use of the present owners of the property, and those who purchase, mortgage, or guarantee the title thereto within one year from date hereof"

THIS IS NOT AN ORIGINAL PRINT  
UNLESS THIS SEAL IS RED

*Robert J. Wetzel*  
ROBERT J. WETZEL  
REGISTERED LAND SURVEYOR - 1778

3/10/92  
DATE

808  
JOB NUMBER

216-1667

FA-2028-1



PLAT OF SURVEY  
-OF-

LOT 1, CERTIFIED SURVEY MAP No. 2028, being located in the Northwest 1/4 of the Northwest 1/4 of Section 28, Township 2 North, Range 16 East in the Township of Delavan, Walworth County, Wisconsin.

Proposed house was staked on actual corners with 5 foot control on the longest house line. The Contractor will be responsible to field verify all stakes for location and dimension prior to construction. If any discrepancies should arise, notify this office at once.


Survey For: American Dream Builders

Proposed Address: \_\_\_\_\_ Sage Road  
Proposed Yd. Gr.: \_\_\_\_\_  
Proposed Fn. Fl.: \_\_\_\_\_

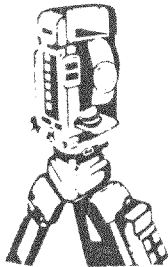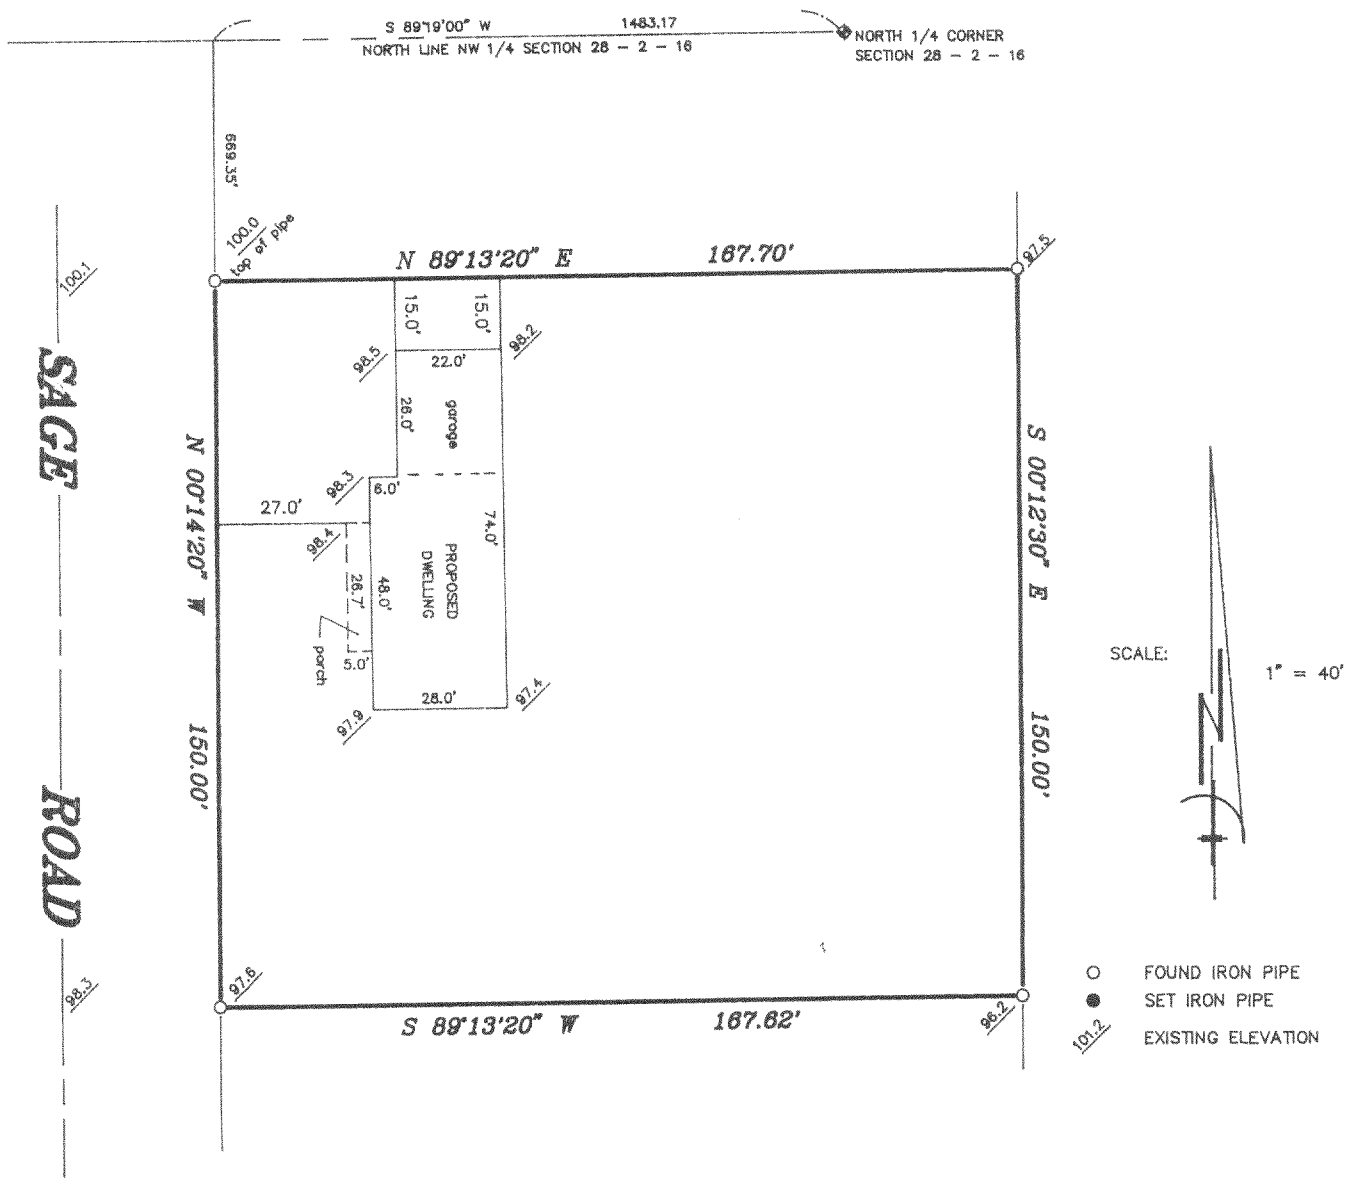

**B.W. SURVEYING**

Land Surveys  
Mapping And Planning  
35117 Academy Road  
Burlington, Wisconsin 53105  
(414) 534-4109

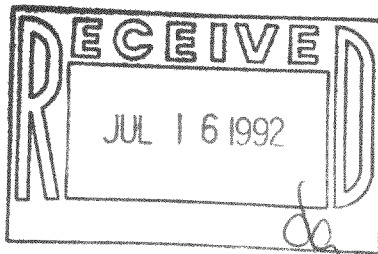

"I hereby certify that I have surveyed the above described property and that the above map is a true representation thereof and shows the size and location of the property, its exterior boundaries, the location of all visible structures and dimensions of all principal buildings thereon, boundary fences, apparent easements, roadways and encroachments, if any.

"This survey is made for the use of the present owners of the property, and those who purchase, mortgage, or guarantee the title thereto within one year from date hereof"

THIS IS NOT AN ORIGINAL PRINT  
UNLESS THIS SEAL IS RED

*Robert J. Wetzel*

ROBERT J. WETZEL  
REGISTERED LAND SURVEYOR - 1778

3/10/92  
DATE

808  
JOB NUMBER