
DUNHAM SURVEYING, S.C. SURVEYING & SUBDIVIDING DELAVAN, WISCONSIN 53115

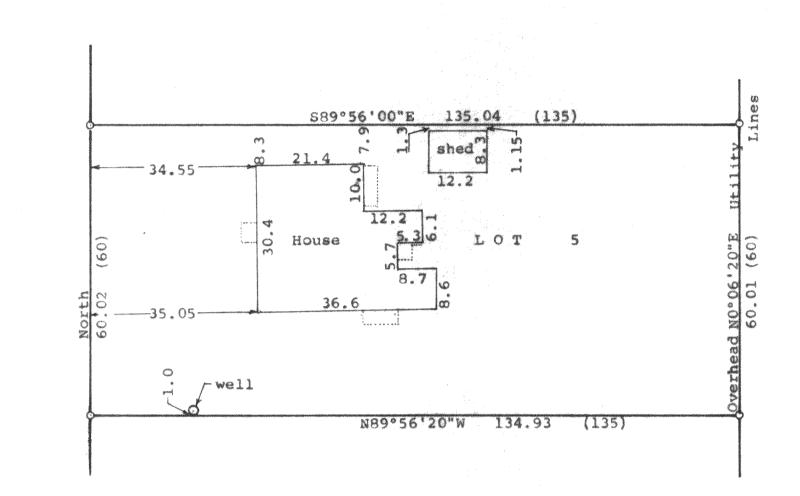

Scale - 1" = 20' •= 1" Iron Pipe Found (0.00) = recorded distance Bearings referenced to the east line of South Shore Drive with the assumed bearing of North Survey ordered by: Century 21, Skandia Realty 312 South 7th street Delavan, WI 53115

STATE OF WISCONSIN) SS

COUNTY OF WALWORTH)

I, George T. Dunham, Surveyor, certify that I have surveyed the property described as follows:

> Lot 5 in Block 15 of Delmar Subdivision located in Section 27, T 2 N, R 16 E, Walworth County, Wisconsin

and that the plat shown hereon is a correct representation thereof and shows the size and location of the property, its exterior boundaries, the location of all visible structures and dimensions of all principal buildings thereon, boundary fences, apparent easements, roadways and visible encroachments, if any, and that I have surveyed the property hereon described, according to the official records, to the best of my knowledge and belief. April 20, 1992



