


ABELL  
SURVEYING & MAPPING


DELAVAN, WISCONSIN 53115

414-728-6737

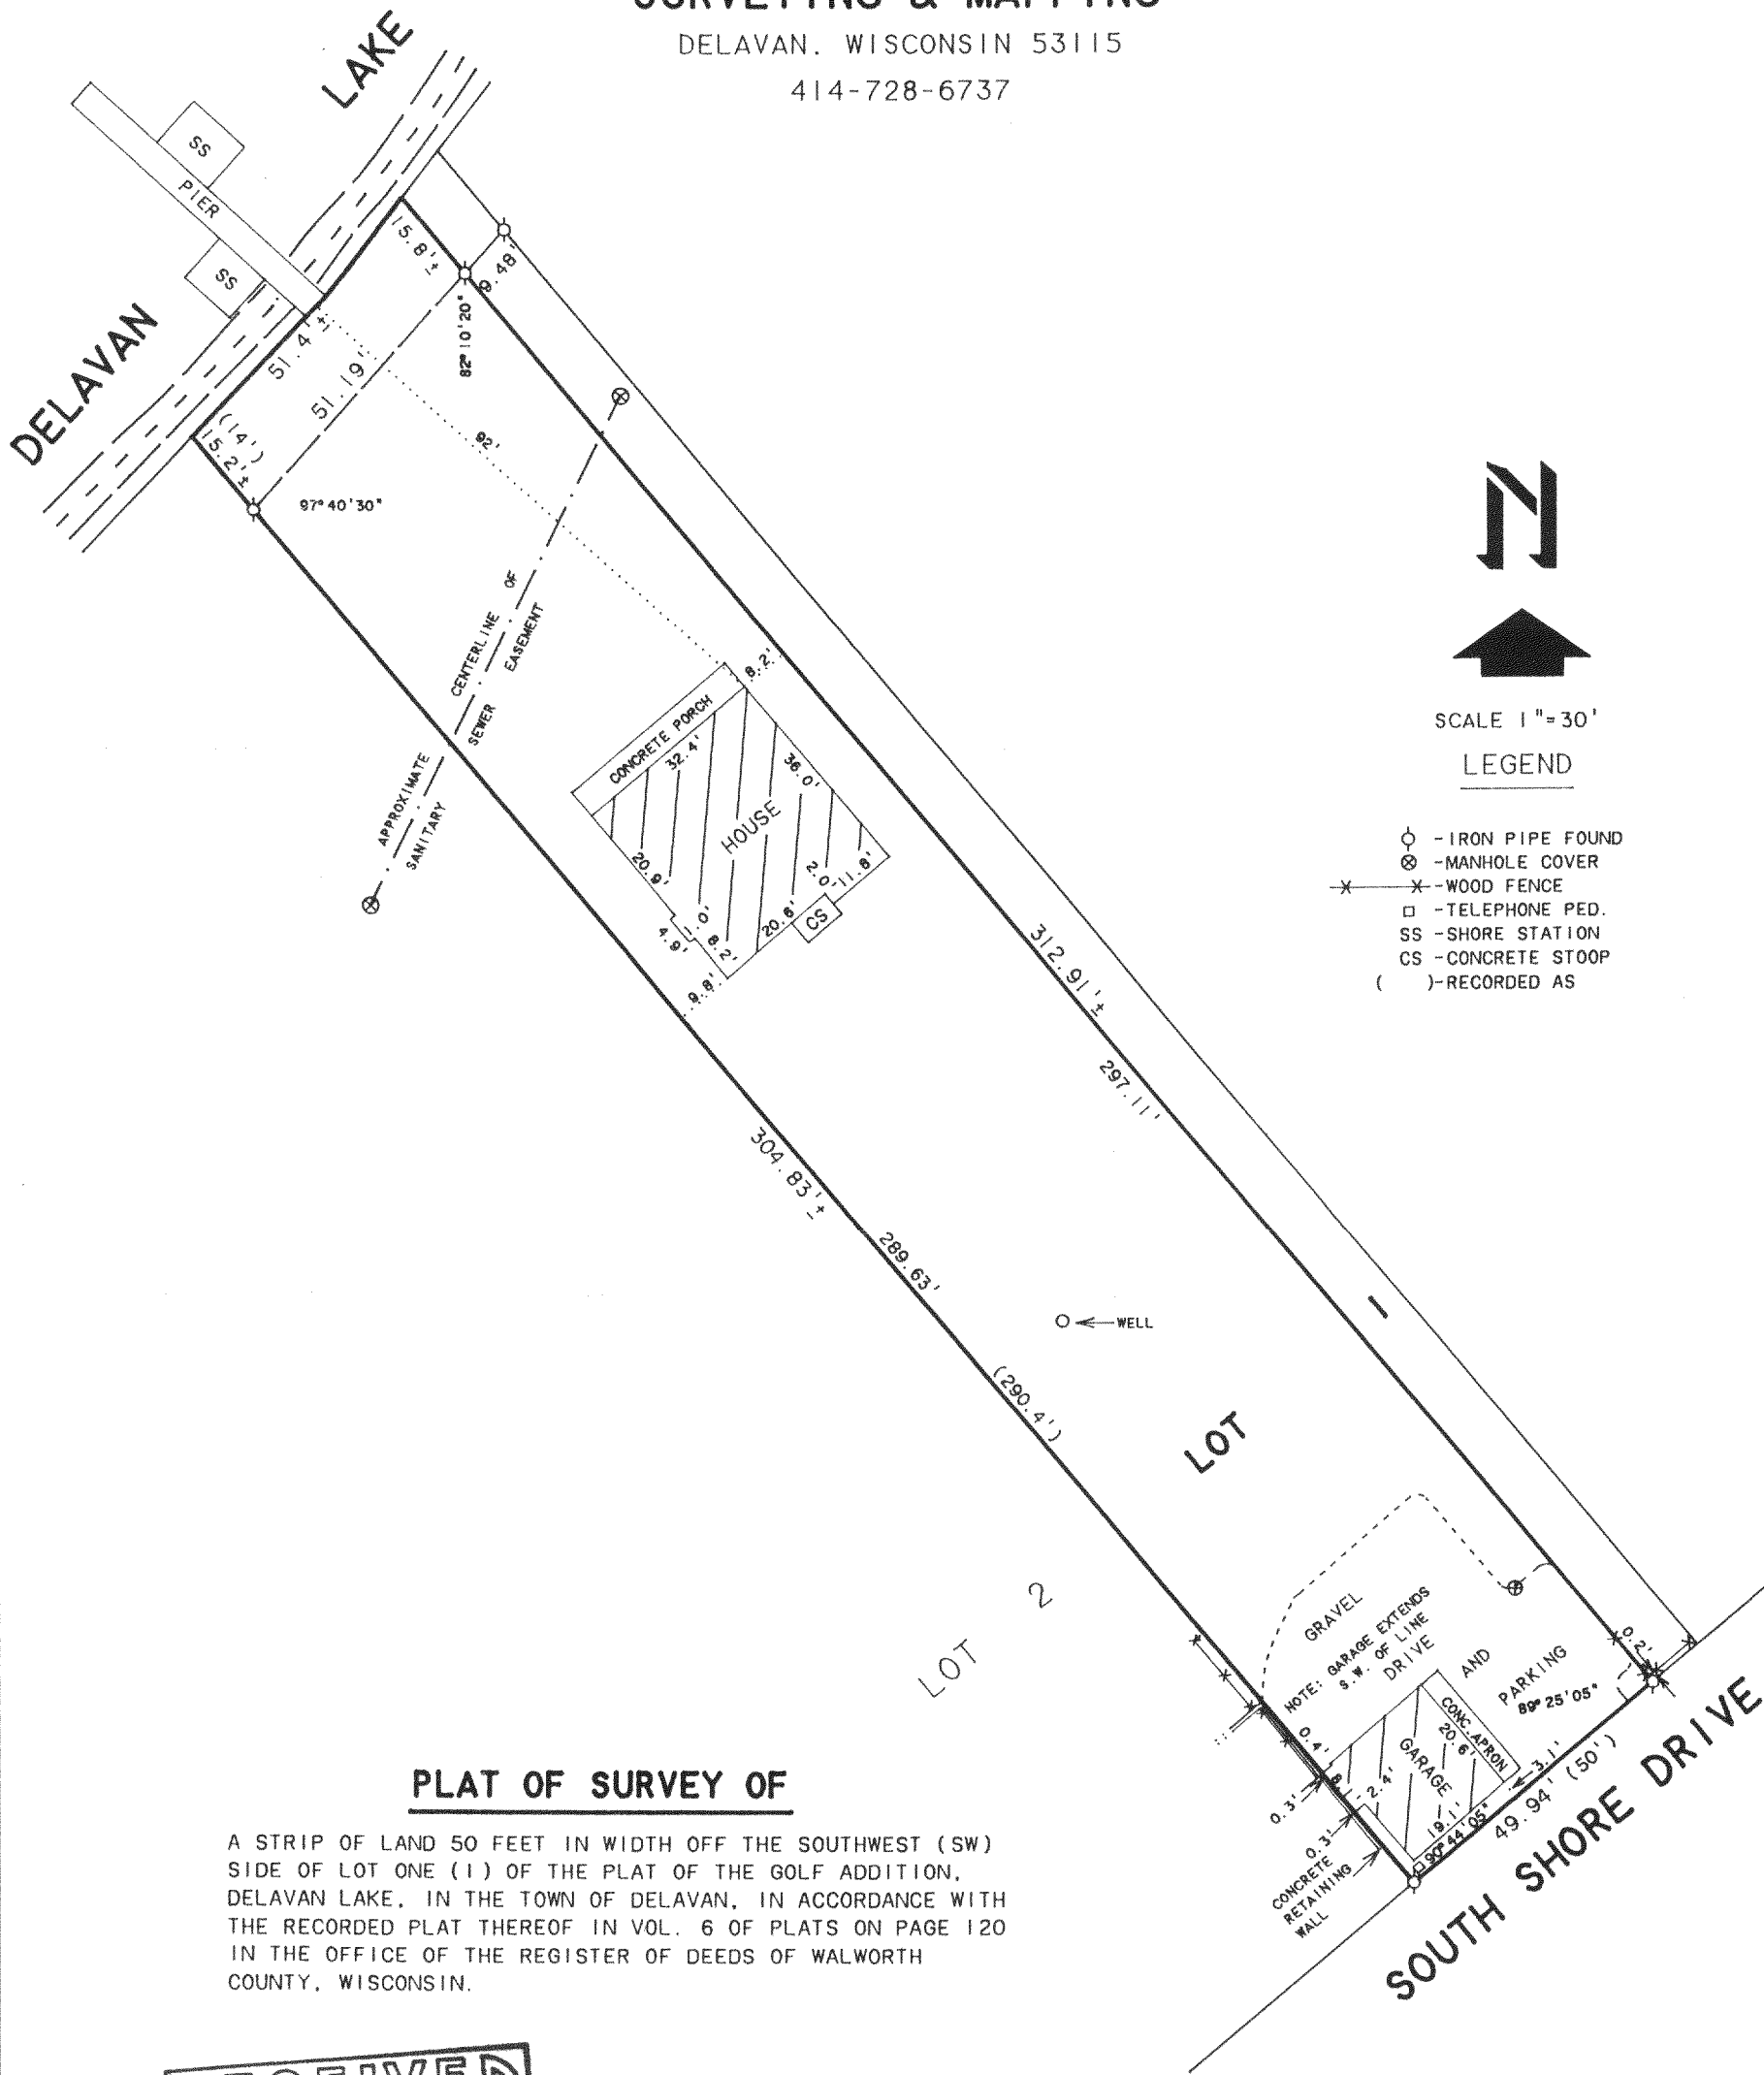

**PLAT OF SURVEY OF**

A STRIP OF LAND 50 FEET IN WIDTH OFF THE SOUTHWEST (SW) SIDE OF LOT ONE (1) OF THE PLAT OF THE GOLF ADDITION, DELAVAN LAKE, IN THE TOWN OF DELAVAN, IN ACCORDANCE WITH THE RECORDED PLAT THEREOF IN VOL. 6 OF PLATS ON PAGE 120 IN THE OFFICE OF THE REGISTER OF DEEDS OF WALWORTH COUNTY, WISCONSIN.

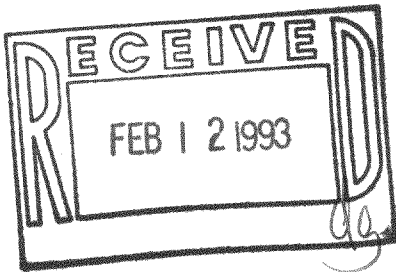

ORDERED BY: CENTURY 21-SKANDIA REALTY  
312 S. 7th STREET  
DELAVAN, WI. 53115

I HEREBY CERTIFY THAT I HAVE SURVEYED THE ABOVE DESCRIBED PROPERTY AND THAT THE ABOVE MAP IS A TRUE REPRESENTATION THEREOF AND SHOWS THE SIZE AND LOCATION OF THE PROPERTY, ITS EXTERIOR BOUNDARIES, THE LOCATION OF ALL VISIBLE STRUCTURES AND DIMENSIONS OF ALL PRINCIPAL BUILDINGS THEREON, BOUNDARY FENCES, APPARENT EASEMENTS, ROADWAYS AND VISIBLE ENCROACHMENTS, IF ANY, TO THE BEST OF MY KNOWLEDGE AND BELIEF.

THIS SURVEY IS MADE FOR THE USE OF THE PRESENT OWNERS OF THE PROPERTY, AND ALSO THOSE WHO PURCHASE, MORTGAGE, OR GUARANTEE THE TITLE THERETO WITHIN ONE (1) YEAR FROM DATE HEREON.

*David F. Abell*

DAVID F. ABELL  
WISCONSIN REGISTERED LAND SURVEYOR, S-1596

*August 27, 1992*

DATE: August 27, 1992 JOB NUMBER - 92183  
NOTE: THIS IS NOT A CERTIFIED COPY UNLESS SEALED.