
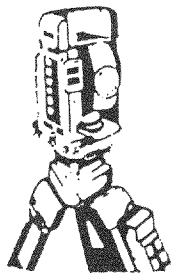



PLAT OF SURVEY
-OF-

LOTS 5, 6 & 7, BLOCK 1, INLET OAKS SUBDIVISION No. 4, located in Section 15, Township 2 North, Range 16 East in the Town of Delavan, County of Walworth and State of Wisconsin.

Survey For: Barney Hanna
Survey Location: 527 Delavan Drive

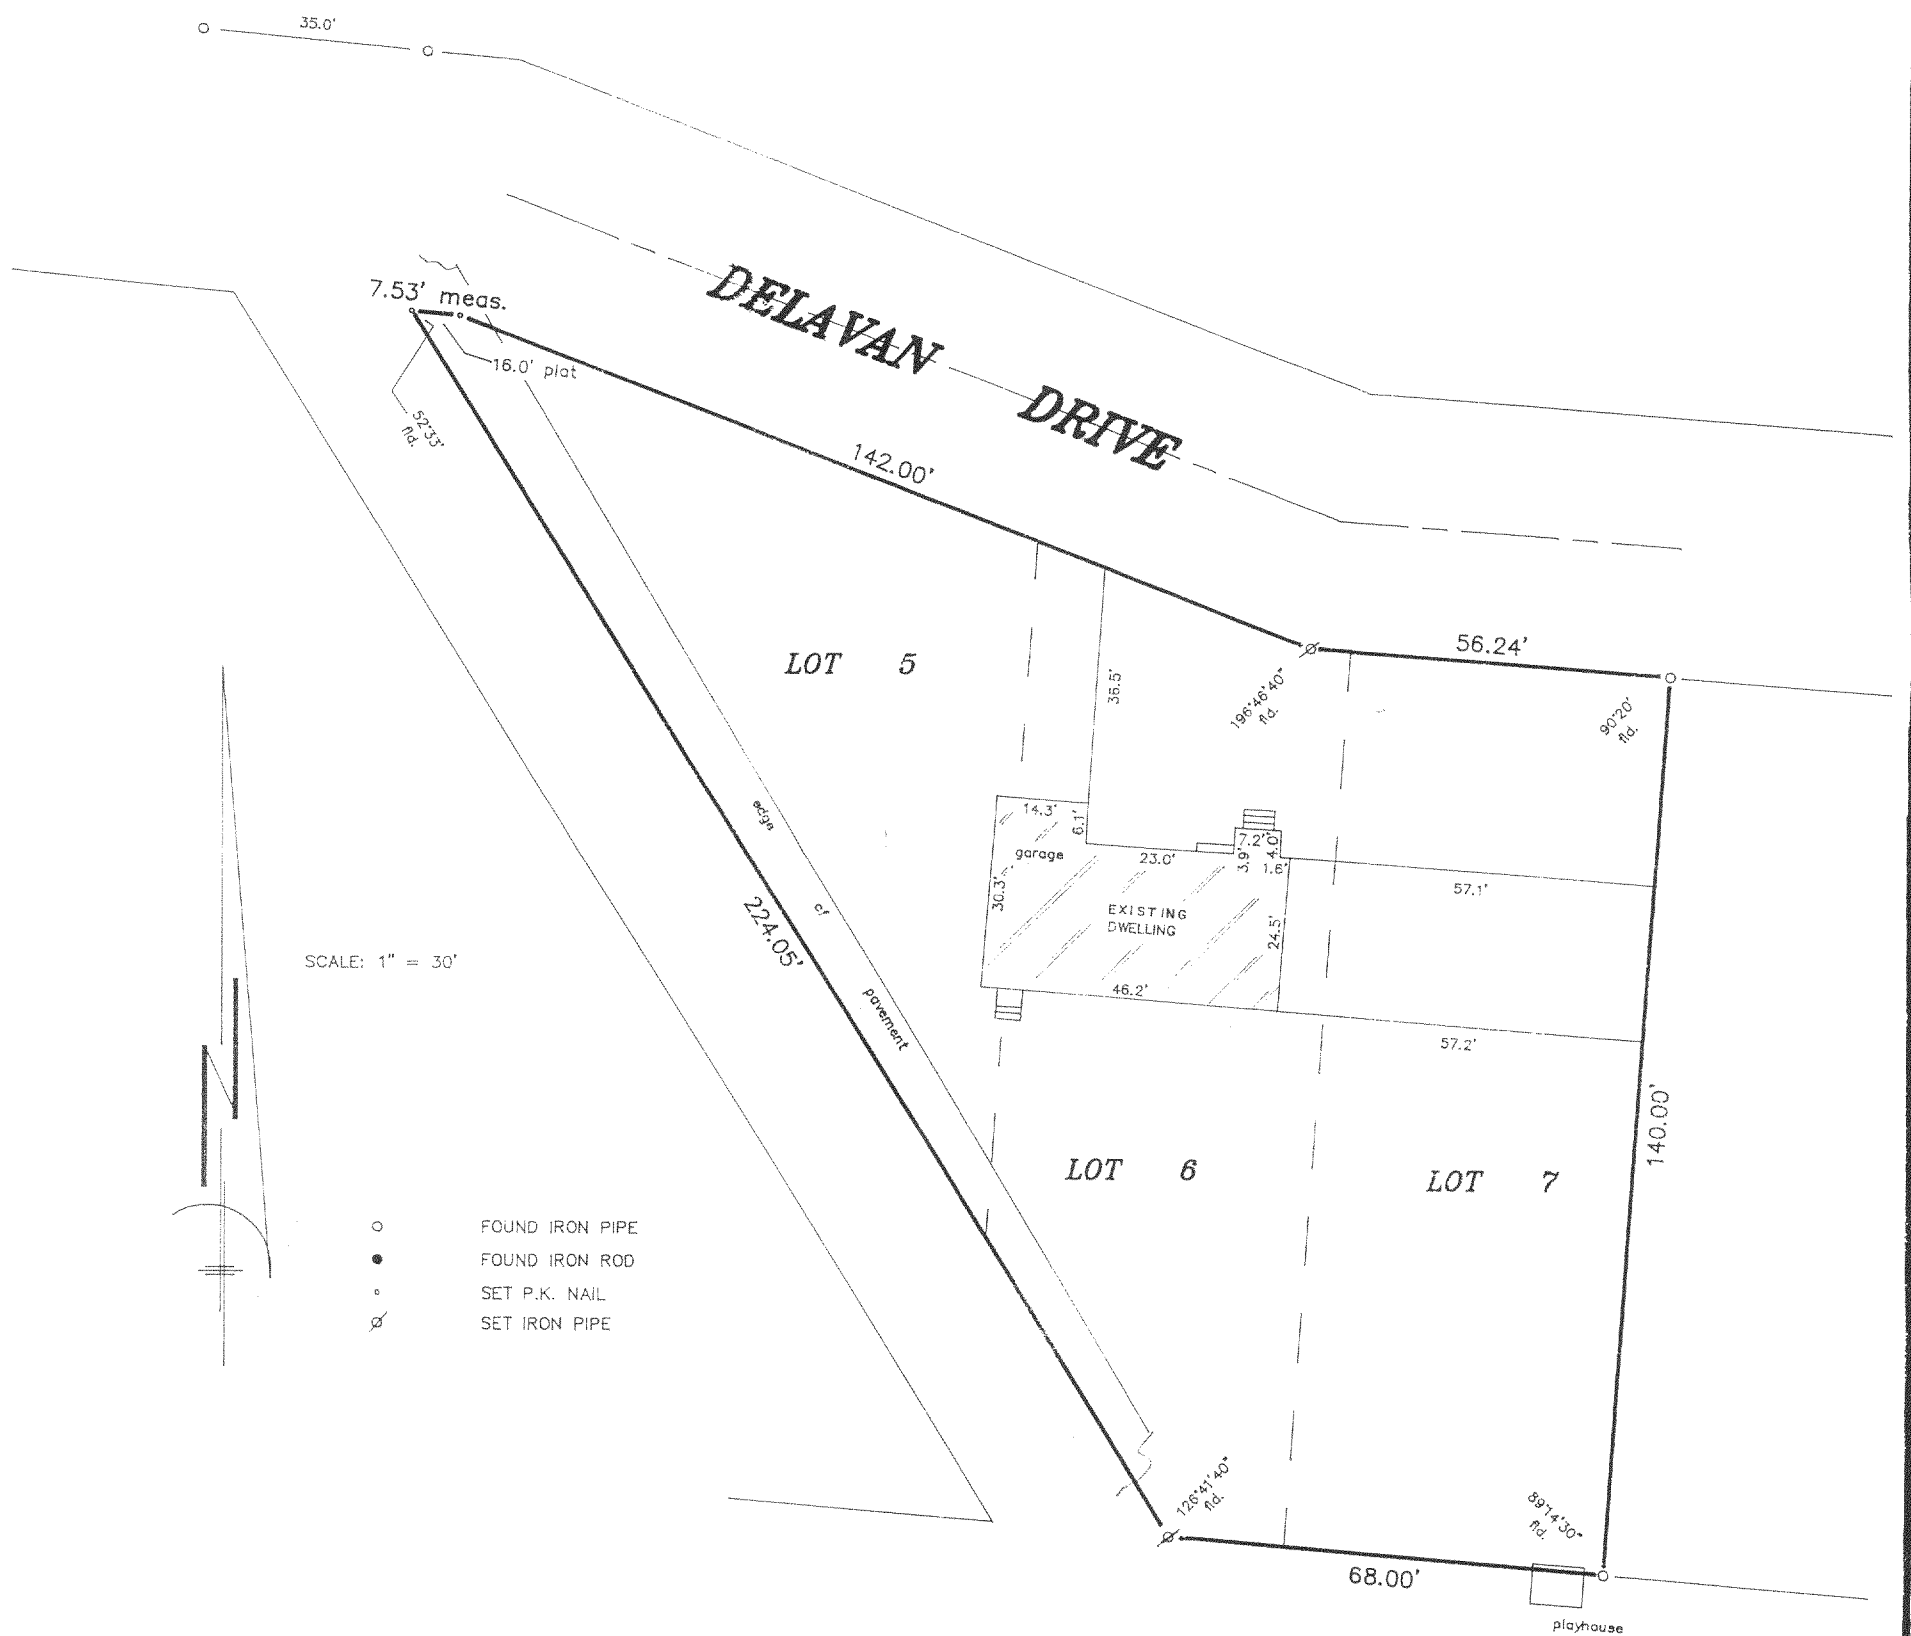


B.W. SURVEYING
Land Surveys
Mapping And Planning
35117 Academy Road
Burlington, Wisconsin 53105
(414) 534-4109

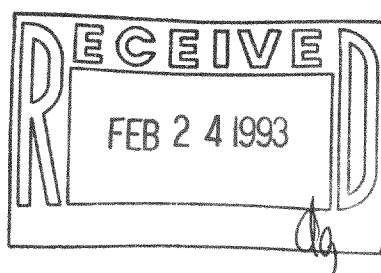

"I hereby certify that I have surveyed the above described property and that the above map is a true representation thereof and shows the size and location of the property, its exterior boundaries, the location of all visible structures and dimensions of all principal buildings thereon, boundary fences, apparent easements, roadways and encroachments, if any.

"This survey is made for the use of the present owners of the property, and those who purchase, mortgage, or guarantee the title thereto within one year from date hereof"

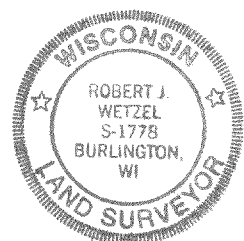

THIS IS NOT AN ORIGINAL PRINT
UNLESS THIS SEAL IS RED

Robert J. Wetzel

ROBERT J. WETZEL
REGISTERED LAND SURVEYOR - 1778

8/7/92
DATE

980
JOB NUMBER