


DUNHAM SURVEYING, S.C.
SURVEYING & SUBDIVIDING
DELAVER, WISCONSIN 53115

N

Scale - 1" = 20'
o = Iron Pipe Found
Bearings are those on the recorded plat of
Delmar
Survey ordered by: Martha Salmon
2604 Tilden
Delavan, WI 53115

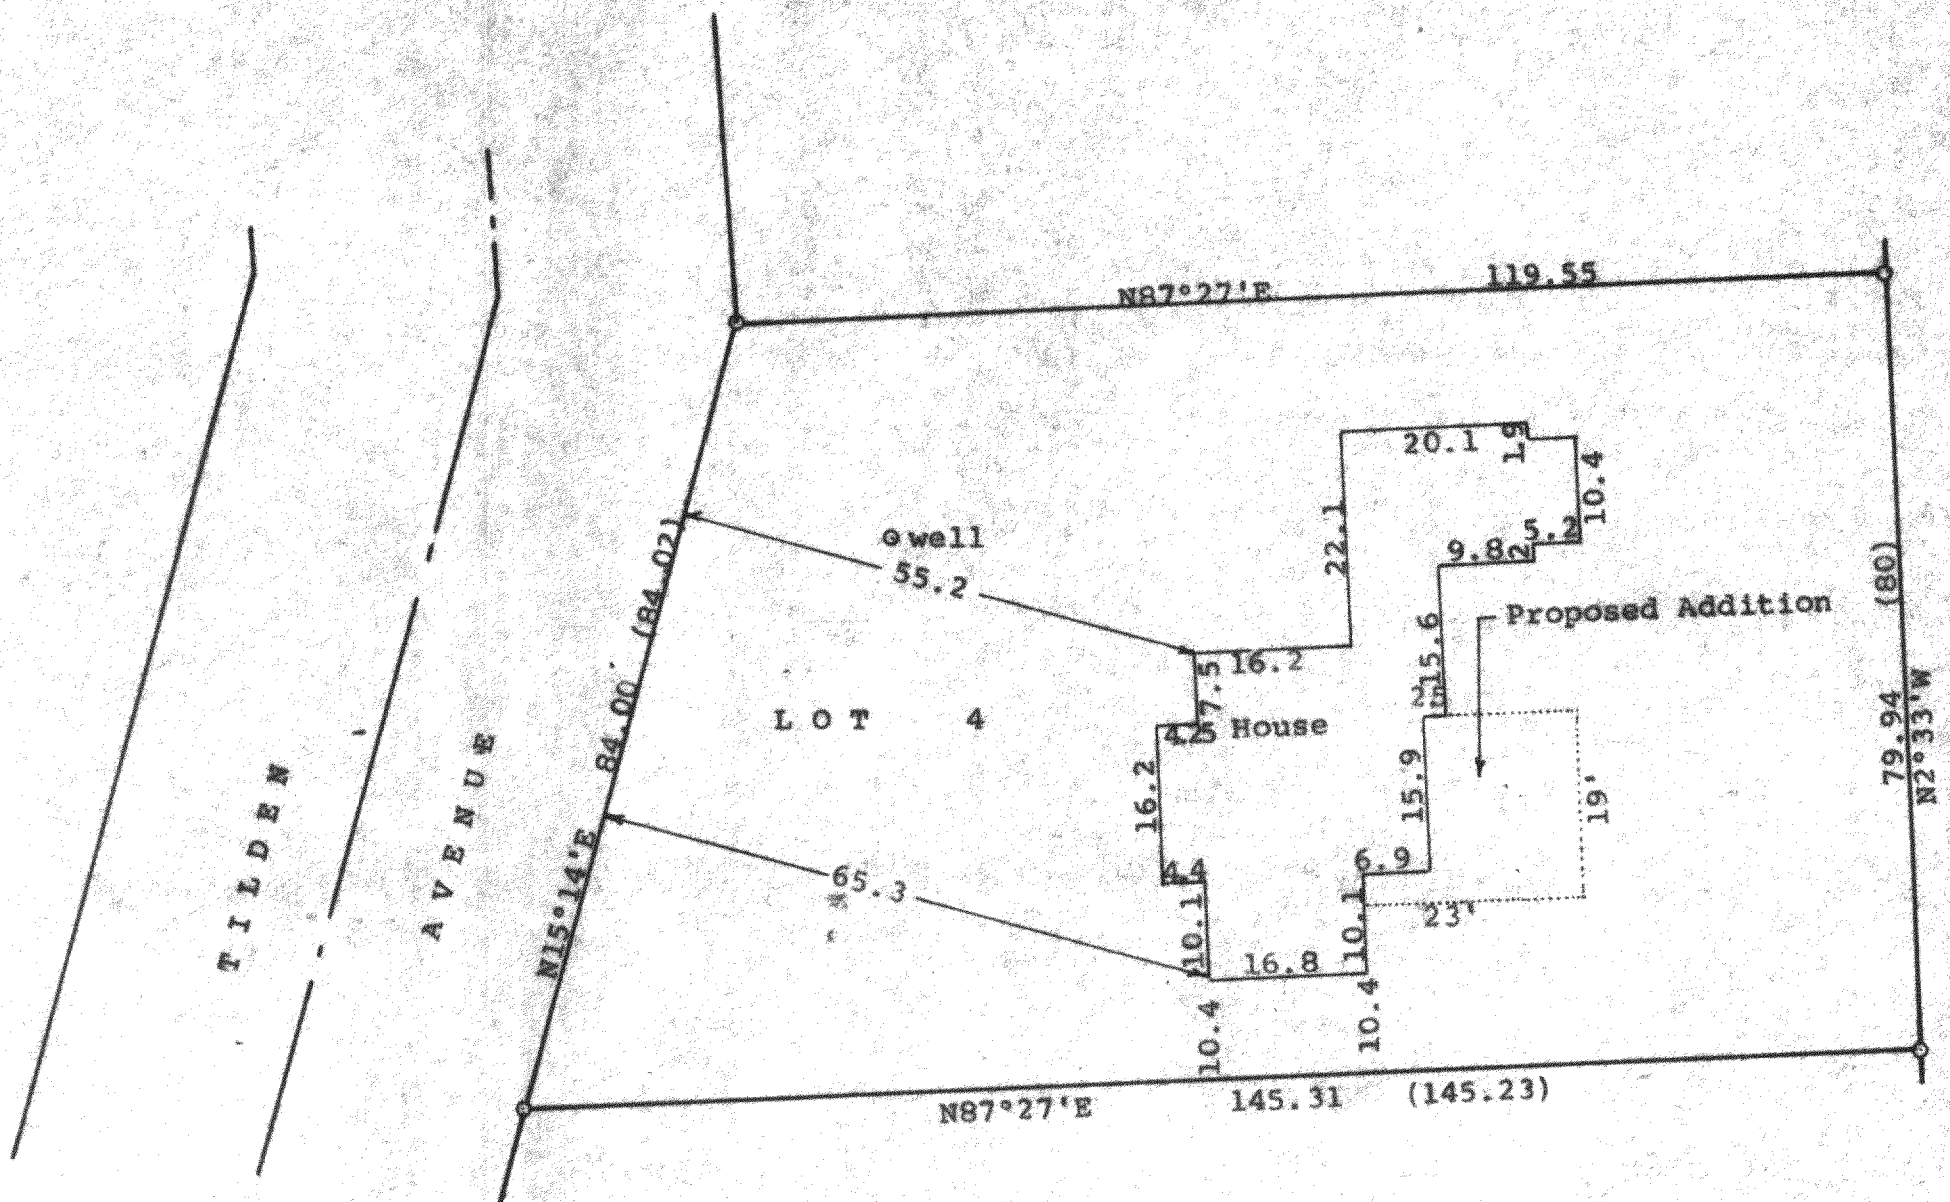

STATE OF WISCONSIN)
COUNTY OF WALWORTH) SS


I, George T. Dunham, Surveyor, certify that I have surveyed the property described as follows:

Lot 4 in Block 7 of Delmar, a subdivision located in Section 27, T 2 N, R 16 E, Walworth County, Wisconsin, subject to easements of record, and that the plat shown hereon is a correct representation thereof and shows the size and location of the property, its exterior boundaries, the location of all visible structures and dimensions of all principal buildings thereon, apparent easements, roadways and visible encroachments, if any, and that I have surveyed the property hereon described, according to the official records to the best of my knowledge and belief.


February 2, 1993

Revised April 2, 1993

George T. Dunham
George T. Dunham, Surveyor

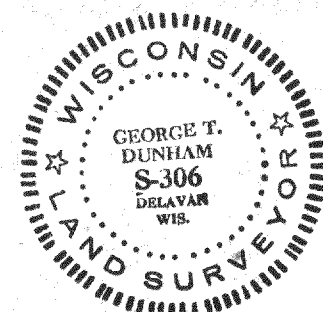

FDM-34B

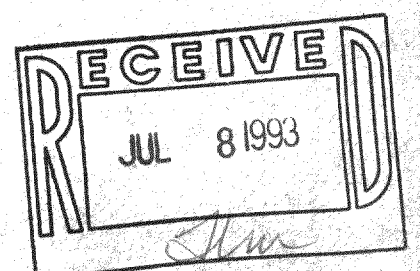

216-1799