
## DUNHAM SURVEYING, S.C. SURVEYING & SUBDIVIDING DELAVAN, WISCONSIN 53115

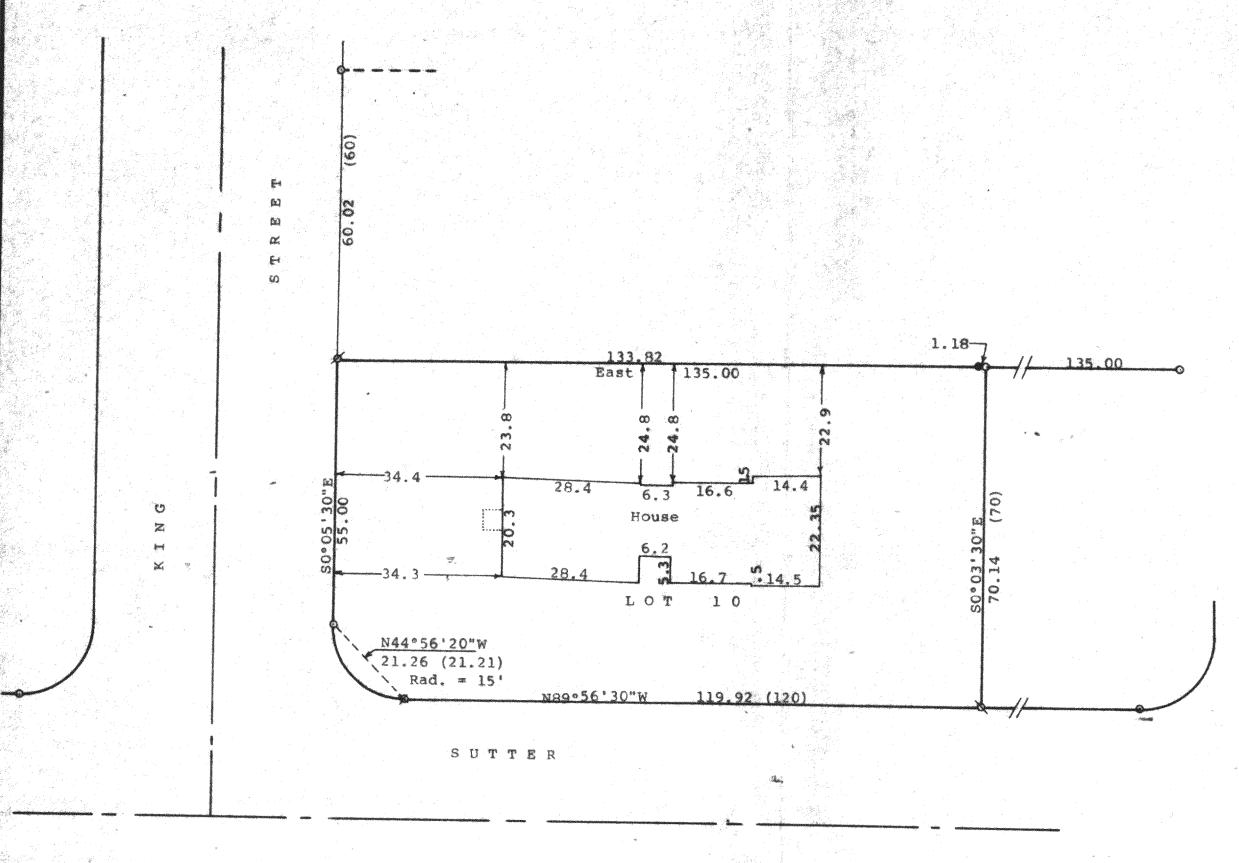

AVENUE

STATE OF WISCONSIN) SS COUNTY OF WALWORTH)

I, George T. Dunham, Surveyor, certify that I have surveyed the property described as follows:

Lot 10 in Block 13 of Delmar Subdivision located in Section 27,

T 2 N, R 16 E, Walworth County, Wisconsin, and that the plat shown hereon is a correct representation thereof and shows the size and location of the property, its exterior boundaries, the location of all visible structures and dimensions of all principal buildings thereon, boundary fences, apparent easements, roadways and visible encroachments, if any, and that I have surveyed the property hereon described, according to the official records, to the best of my knowledge and belief.

May 25, 1993

George T. Dunham, Surveyor

Scale - 1" = 20'

0 = 1" Iron Pipe Found

• = 1/3" Iron Pipe Found. Did not use

Ø = 3/4" Iron Pipe Found

% = 1" Iron Pipe Found up 1' above ground. Reset flush with ground and correct corner

Survey ordered by: Century 21, Skandia

Realty

312 South 7th Street

Delavan, WI 53115

(0.00) = recorded distance

▼ = 3/4" Iron Pipe Set



