

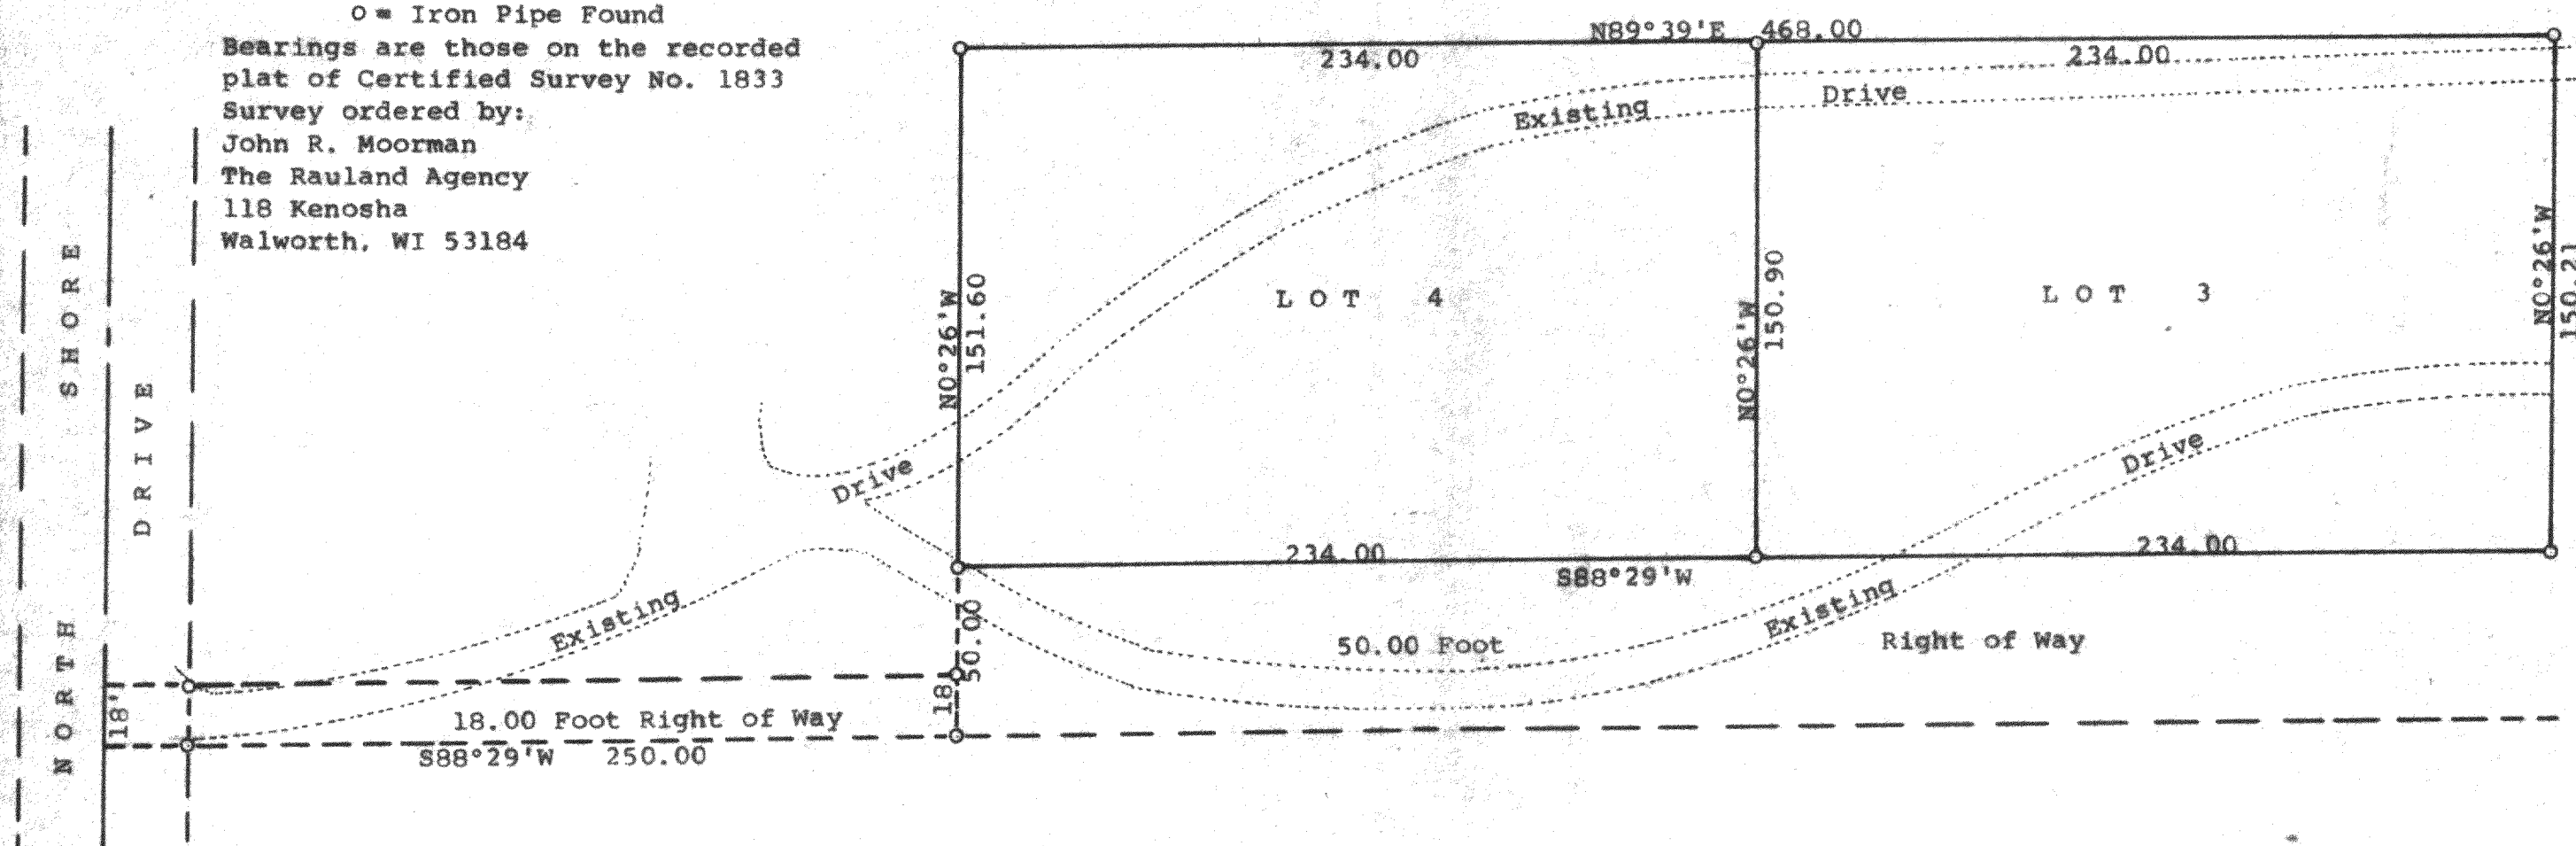


Bearings are those on the recorded
plat of Certified Survey No. 1833
Survey ordered by:
John R. Moorman
The Rauland Agency
118 Kenosha
Walworth, WI 53184

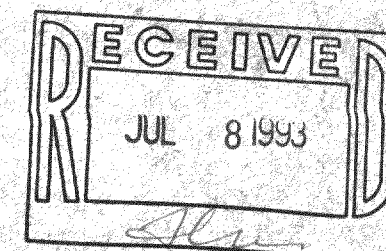

George T. Dunham
George T. Dunham, Surveyor

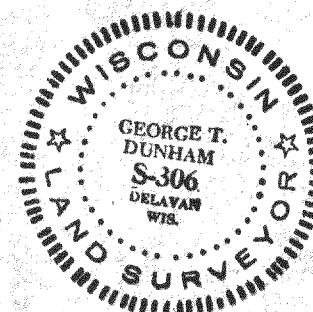

216-1812