


ABELL  
SURVEYING & MAPPING  
DELAVAN, WISCONSIN 53115  
414-728-6737

DELAVAN LAKE

PLAT OF SURVEY OF

LOT 2, THE GOLF ADDITION, LOCATED IN  
T2N, R16E, WALWORTH COUNTY, WISCONSIN.

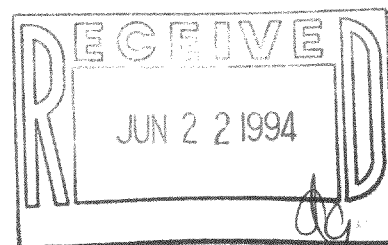

END OF FENCE  
ON LINE

N 38°00'54" W

LOT 3

LOT 2

LOT 1

NOTE: DRIVEWAY AND SIDEWALKS NOT  
LOCATED DUE TO HEAVY SNOW  
COVER ON DATE OF SURVEY.  
THE LOCATION OF THE BLACKTOP  
DRIVE IS FROM EXISTING SURVEY  
RECORDS.

ORDERED BY: THE RAULAND AGENCY  
P.O. BOX 159  
WALWORTH, WI. 53184

NOTE: BEARINGS ARE REFERENCED TO  
EXISTING SURVEY RECORDS.

N



SCALE 1"=30'

LEGEND

- ⊙ -IRON PIPE FOUND
- ⊗ -MANHOLE COVER
- X— -WOOD FENCE
- XX— -CHAINLINK FENCE
- △ -UTILITY POLE
- -OVERHEAD UTILITY LINES
- ( ) -RECORDED AS

I HEREBY CERTIFY THAT I HAVE SURVEYED THE ABOVE DESCRIBED PROPERTY AND THAT THE  
ABOVE MAP IS A TRUE REPRESENTATION THEREOF AND SHOWS THE SIZE AND LOCATION OF  
THE PROPERTY, ITS EXTERIOR BOUNDARIES, THE LOCATION OF ALL VISIBLE STRUCTURES  
AND DIMENSIONS OF ALL PRINCIPAL BUILDINGS THEREON, BOUNDARY FENCES, APPARENT  
EASEMENTS, ROADWAYS AND VISIBLE ENCROACHMENTS, IF ANY, TO THE BEST OF MY  
KNOWLEDGE AND BELIEF.

THIS SURVEY IS MADE FOR THE USE OF THE PRESENT OWNERS OF THE PROPERTY, AND ALSO  
THOSE WHO PURCHASE, MORTGAGE, OR GUARANTEE THE TITLE THERETO WITHIN ONE (1) YEAR  
FROM DATE HEREON.

*David F. Abell*

DAVID F. ABELL  
WISCONSIN REGISTERED LAND SURVEYOR, S-1596

February 11, 1994

DATE JOB NUMBER - 94012  
NOTE: THIS IS NOT A CERTIFIED COPY UNLESS SEALED.