

414-728-6737

OVERHEAD WIRES

ROADWAY RECORDED AS BLOCK "D" (14')

60.00' (30') 60.00' (30') 12.0' 9.4'

89°49' 90°11'

GRAVEL DRIVE

LOT 22 59.71'

LOT 21

LOT 20 24.5' 28.4'

HOUSE

LOT 19 59.71'

WELL 8.0'

12.1'

20.3'

GARAGE

WOOD DECK

B E


60.07' (60') 90°11' (30') 60.00' (30') 89°49'

**BLOCK**

LOTS 20 AND 21, BLOCK C OF JACKSON'S SUBDIVISION,  
LOCATED IN THE SOUTHEAST 1/4 OF SECTION 21, T2N,  
R16E, WALWORTH COUNTY, WISCONSIN.

ORDERED BY: RE/MAX-LAKES AREA REALTORS  
1815 N. SHORE DRIVE  
DELAVER, WI 53115

NOTE: GRAVEL DRIVEWAY NOT LOCATED DUE TO SNOW COVER ON THE  
DATE OF SURVEY.

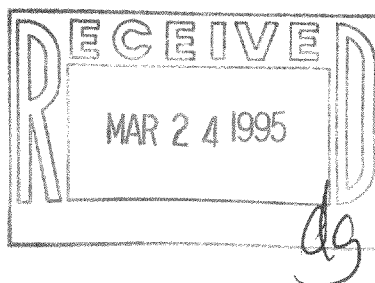

I HEREBY CERTIFY THAT I HAVE SURVEYED THE ABOVE DESCRIBED PROPERTY AND THAT THE ABOVE MAP IS A TRUE REPRESENTATION THEREOF AND SHOWS THE SIZE AND LOCATION OF THE PROPERTY, ITS EXTERIOR BOUNDARIES, THE LOCATION OF ALL VISIBLE STRUCTURES AND DIMENSIONS OF ALL PRINCIPAL BUILDINGS THEREON, BOUNDARY FENCES, APPARENT EASEMENTS, ROADWAYS AND VISIBLE ENCROACHMENTS, IF ANY, TO THE BEST OF MY KNOWLEDGE AND BELIEF.

THIS SURVEY IS MADE FOR THE USE OF THE PRESENT OWNERS OF THE PROPERTY, AND ALSO THOSE WHO PURCHASE, MORTGAGE, OR GUARANTEE THE TITLE THERETO WITHIN ONE (1) YEAR FROM DATE HEREON.

Ø - IRON PIPE FOUND  
 ● - IRON ROD FOUND  
 ○ - IRON ROD SET found 12/14/94  
 ( ) - RECORDED AS  
 BE - BASEMENT ENTRY

<sup>194</sup> David F. Abell  
DAVID F. ABELL  
WISCONSIN REGISTERED L.

March 16, 1988 REVISED: 12/14/94  
DATE JOB NUMBER - 88034

NOTE: THIS IS NOT A CERTIFIED COPY UNLESS SEALED.

FJS-29

216-2068