


## N



George T. Dunham  
George T. Dunham, Surveyor

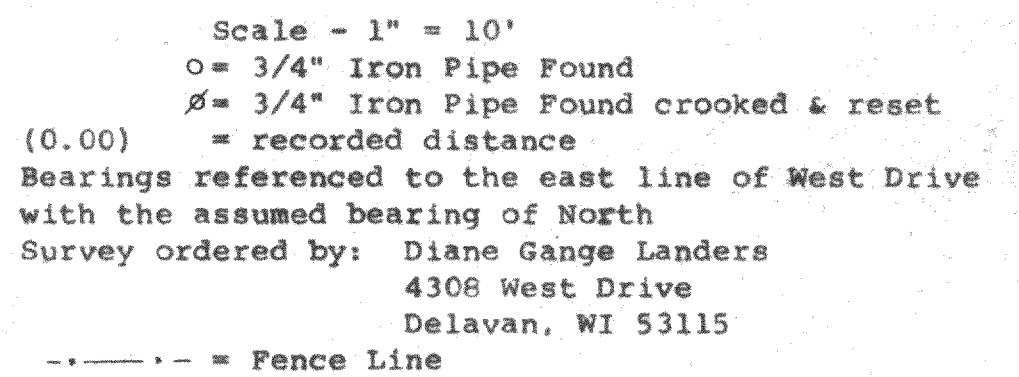