

CEDAR                  POINT                  DRIVE




SCALE 1"=20'

### LEGEND

-  -IRON PIPE FOUND  
 -UTILITY POLE  
 -OVERHEAD UTILITY LINES  
 -GUY WIRE  
 -MANHOLE COVER  
WS  -WOOD STOOP  
-X  -FENCE  
 -UNDERGROUND SPRINKLER HEAD  
( ) -RECORDED AS

LOT 6 AND THE WEST 45 FEET OF LOT 7 OF CEDAR  
POINT SUBDIVISION, LOCATED IN T2N, R16E,  
WALWORTH COUNTY, WISCONSIN.

ORDERED BY: CENTURY 21-SKANDIA REALTY  
312 S. 7th STREET  
DELAVER, WI. 53115

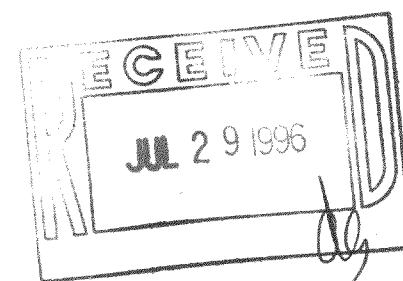

I HEREBY CERTIFY THAT I HAVE SURVEYED THE ABOVE DESCRIBED PROPERTY AND THAT THE ABOVE MAP IS A TRUE REPRESENTATION THEREOF AND SHOWS THE SIZE AND LOCATION OF THE PROPERTY, ITS EXTERIOR BOUNDARIES, THE LOCATION OF ALL VISIBLE STRUCTURES AND DIMENSIONS OF ALL PRINCIPAL BUILDINGS THEREON, BOUNDARY FENCES, APPARENT EASEMENTS, ROADWAYS AND VISIBLE ENCROACHMENTS, IF ANY, TO THE BEST OF MY KNOWLEDGE AND BELIEF.

THIS SURVEY IS MADE FOR THE USE OF THE PRESENT OWNERS OF THE PROPERTY, AND ALSO THOSE WHO PURCHASE, MORTGAGE, OR GUARANTEE THE TITLE THERETO WITHIN ONE (1) YEAR FROM DATE HEREON.

DAVID F. ABELL  
WISCONSIN REGISTERED LAND SURVEYOR. S-1596

April 8, 1996

DATE \_\_\_\_\_ JOB NUMBER - 96036  
NOTE: THIS IS NOT A CERTIFIED COPY UNLESS SEALED.

FC-6

216-2265