


GEORGE T. DUNHAM
SURVEYING & SUBDIVIDING
DELAVER, WISCONSIN

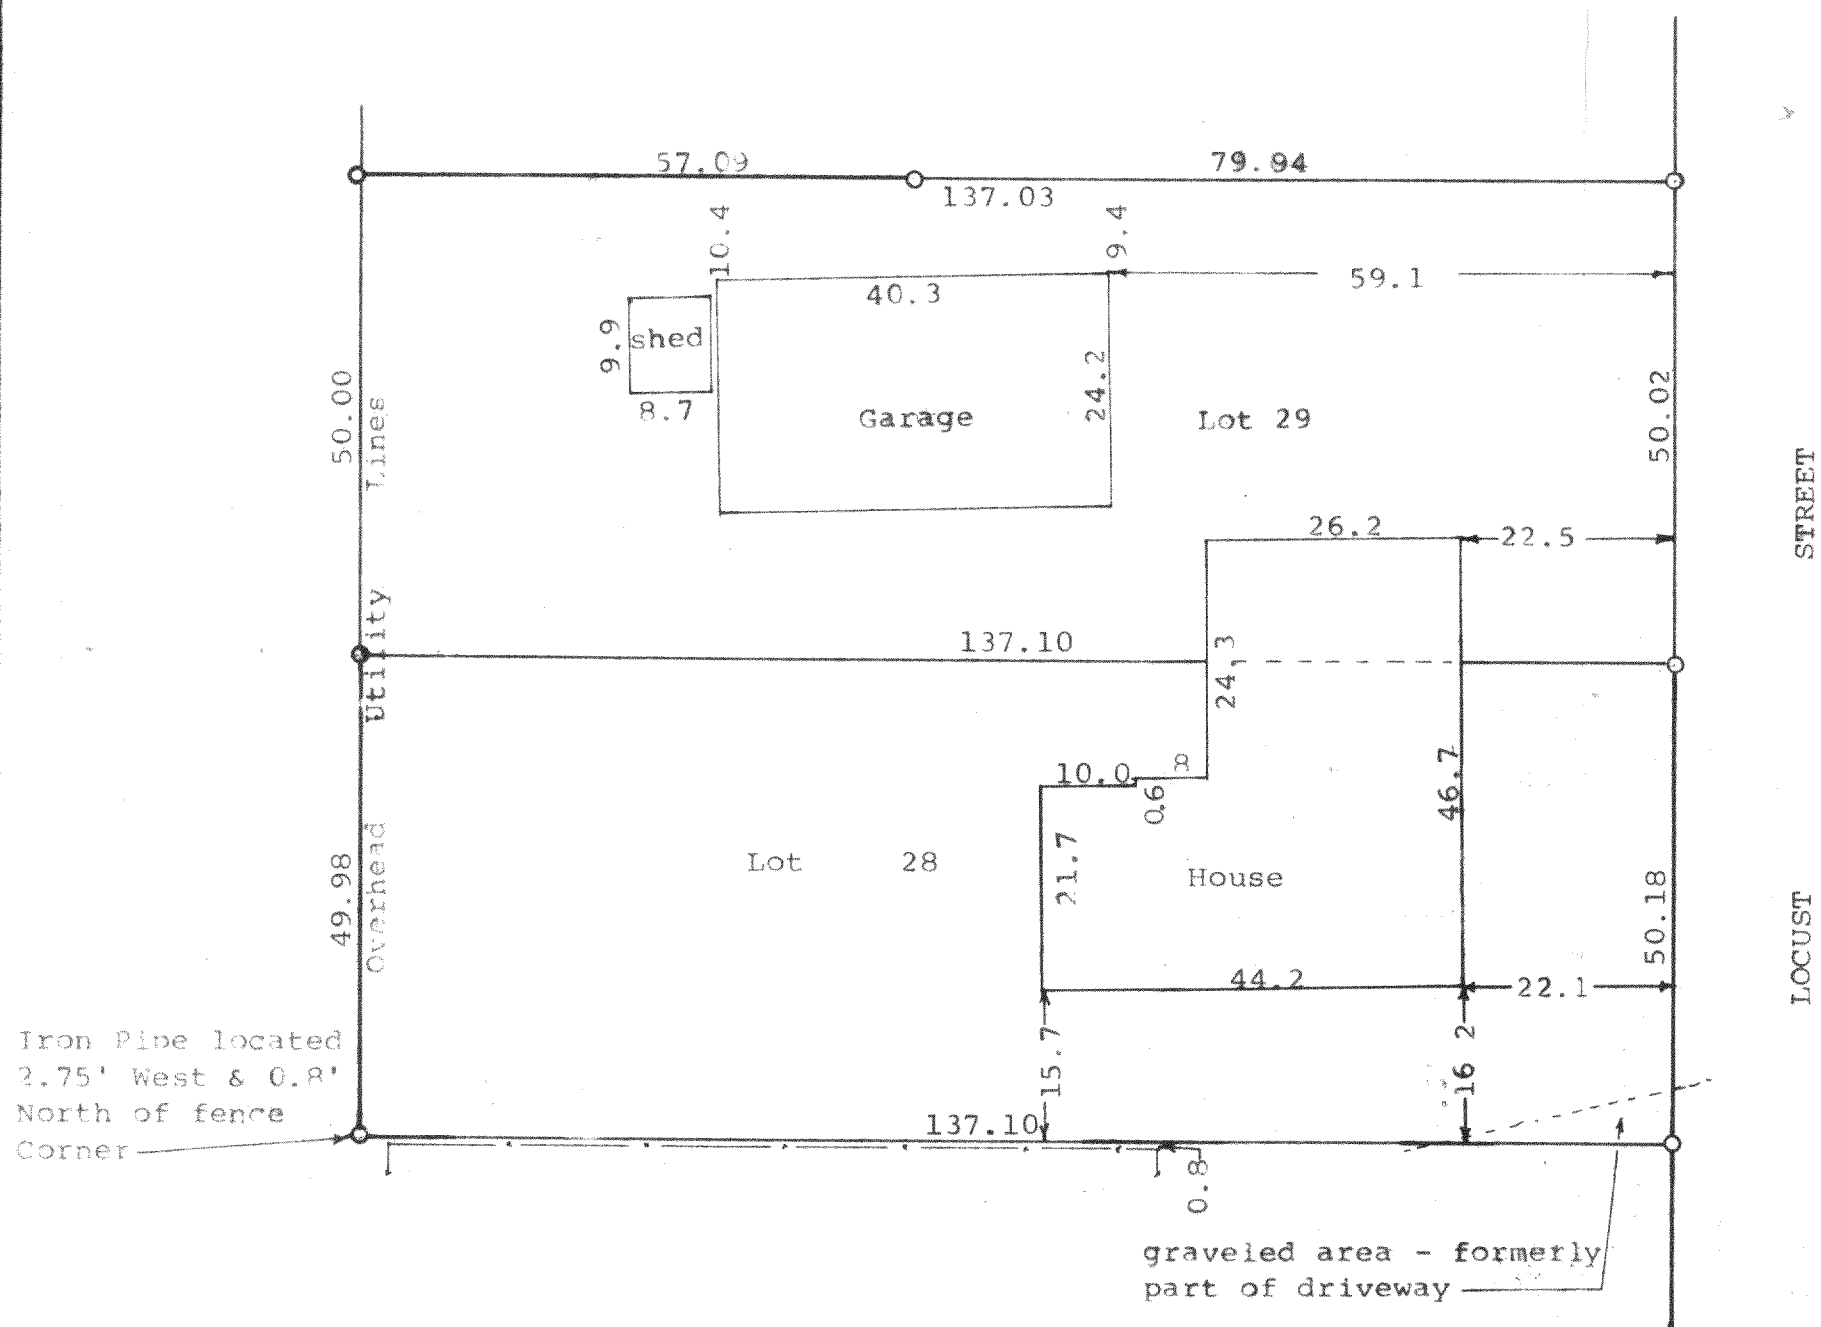

N

Scale - 1" = 20'

○ = Iron Pipe



— = fence line

Plat of survey of Lots 28 and 29 in Lake View Subdivision,
in Section 32, T 2 N, R 16 E, Walworth County, Wisconsin,
as surveyed on October 9, 1969

January 17, 1970

Updated and certified to be correct this 4th day of
March, 1996

George T. Dunham
George T. Dunham, Surveyor

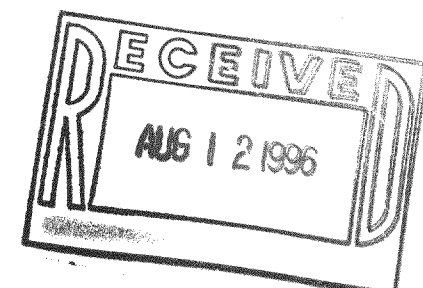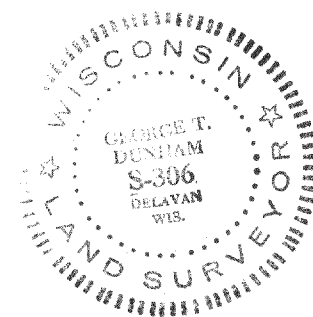

FLAS-25
216-2288