
DUNHAM SURVEYING, S.C. SURVEYING & SUBDIVIDING DELAVAN, WISCONSIN 53115

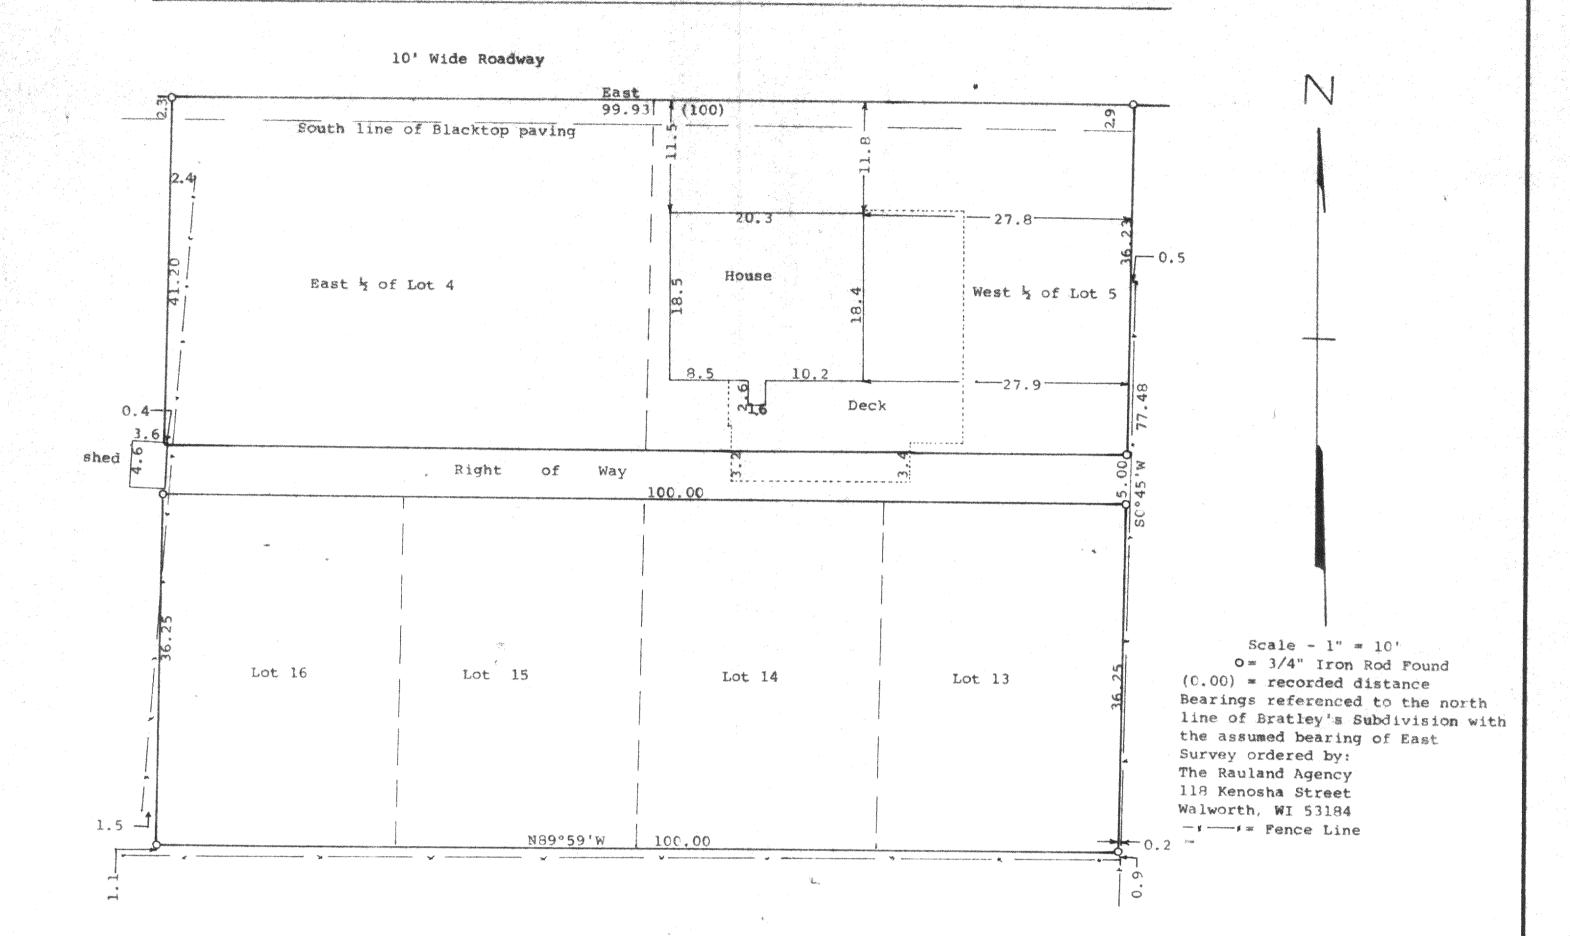

STATE OF WISCONSIN) SS COUNTY OF WALWORTH)

I. George T. Dunham, Surveyor, certify that I have surveyed the property

described as follows:

Lots 13, 14, 15, and 16 of Duncansons Lake Shore Addition and the East 1/2 of Lot 4 and the West 3 of Lot 5 of Bratley's Subdivision all located in in Fractional Section 28, T 2 N, R 16 E, Walworth County, Wisconsin, and that the plat shown hereon is a correct representation thereof and shows the size and location of the property, its exterior boundaries, the location of all visible structures and dimensions of all principal buildings thereon. boundary fences, apparent easements, roadways and visible encroachments, if any, and that I have surveyed the property hereon described, according to the official records, to the best of my knowledge and belief. May 30, 1995

George T. Dunham, Surveyor





FDW-S FBRS-4