


PLAT OF SURVEY

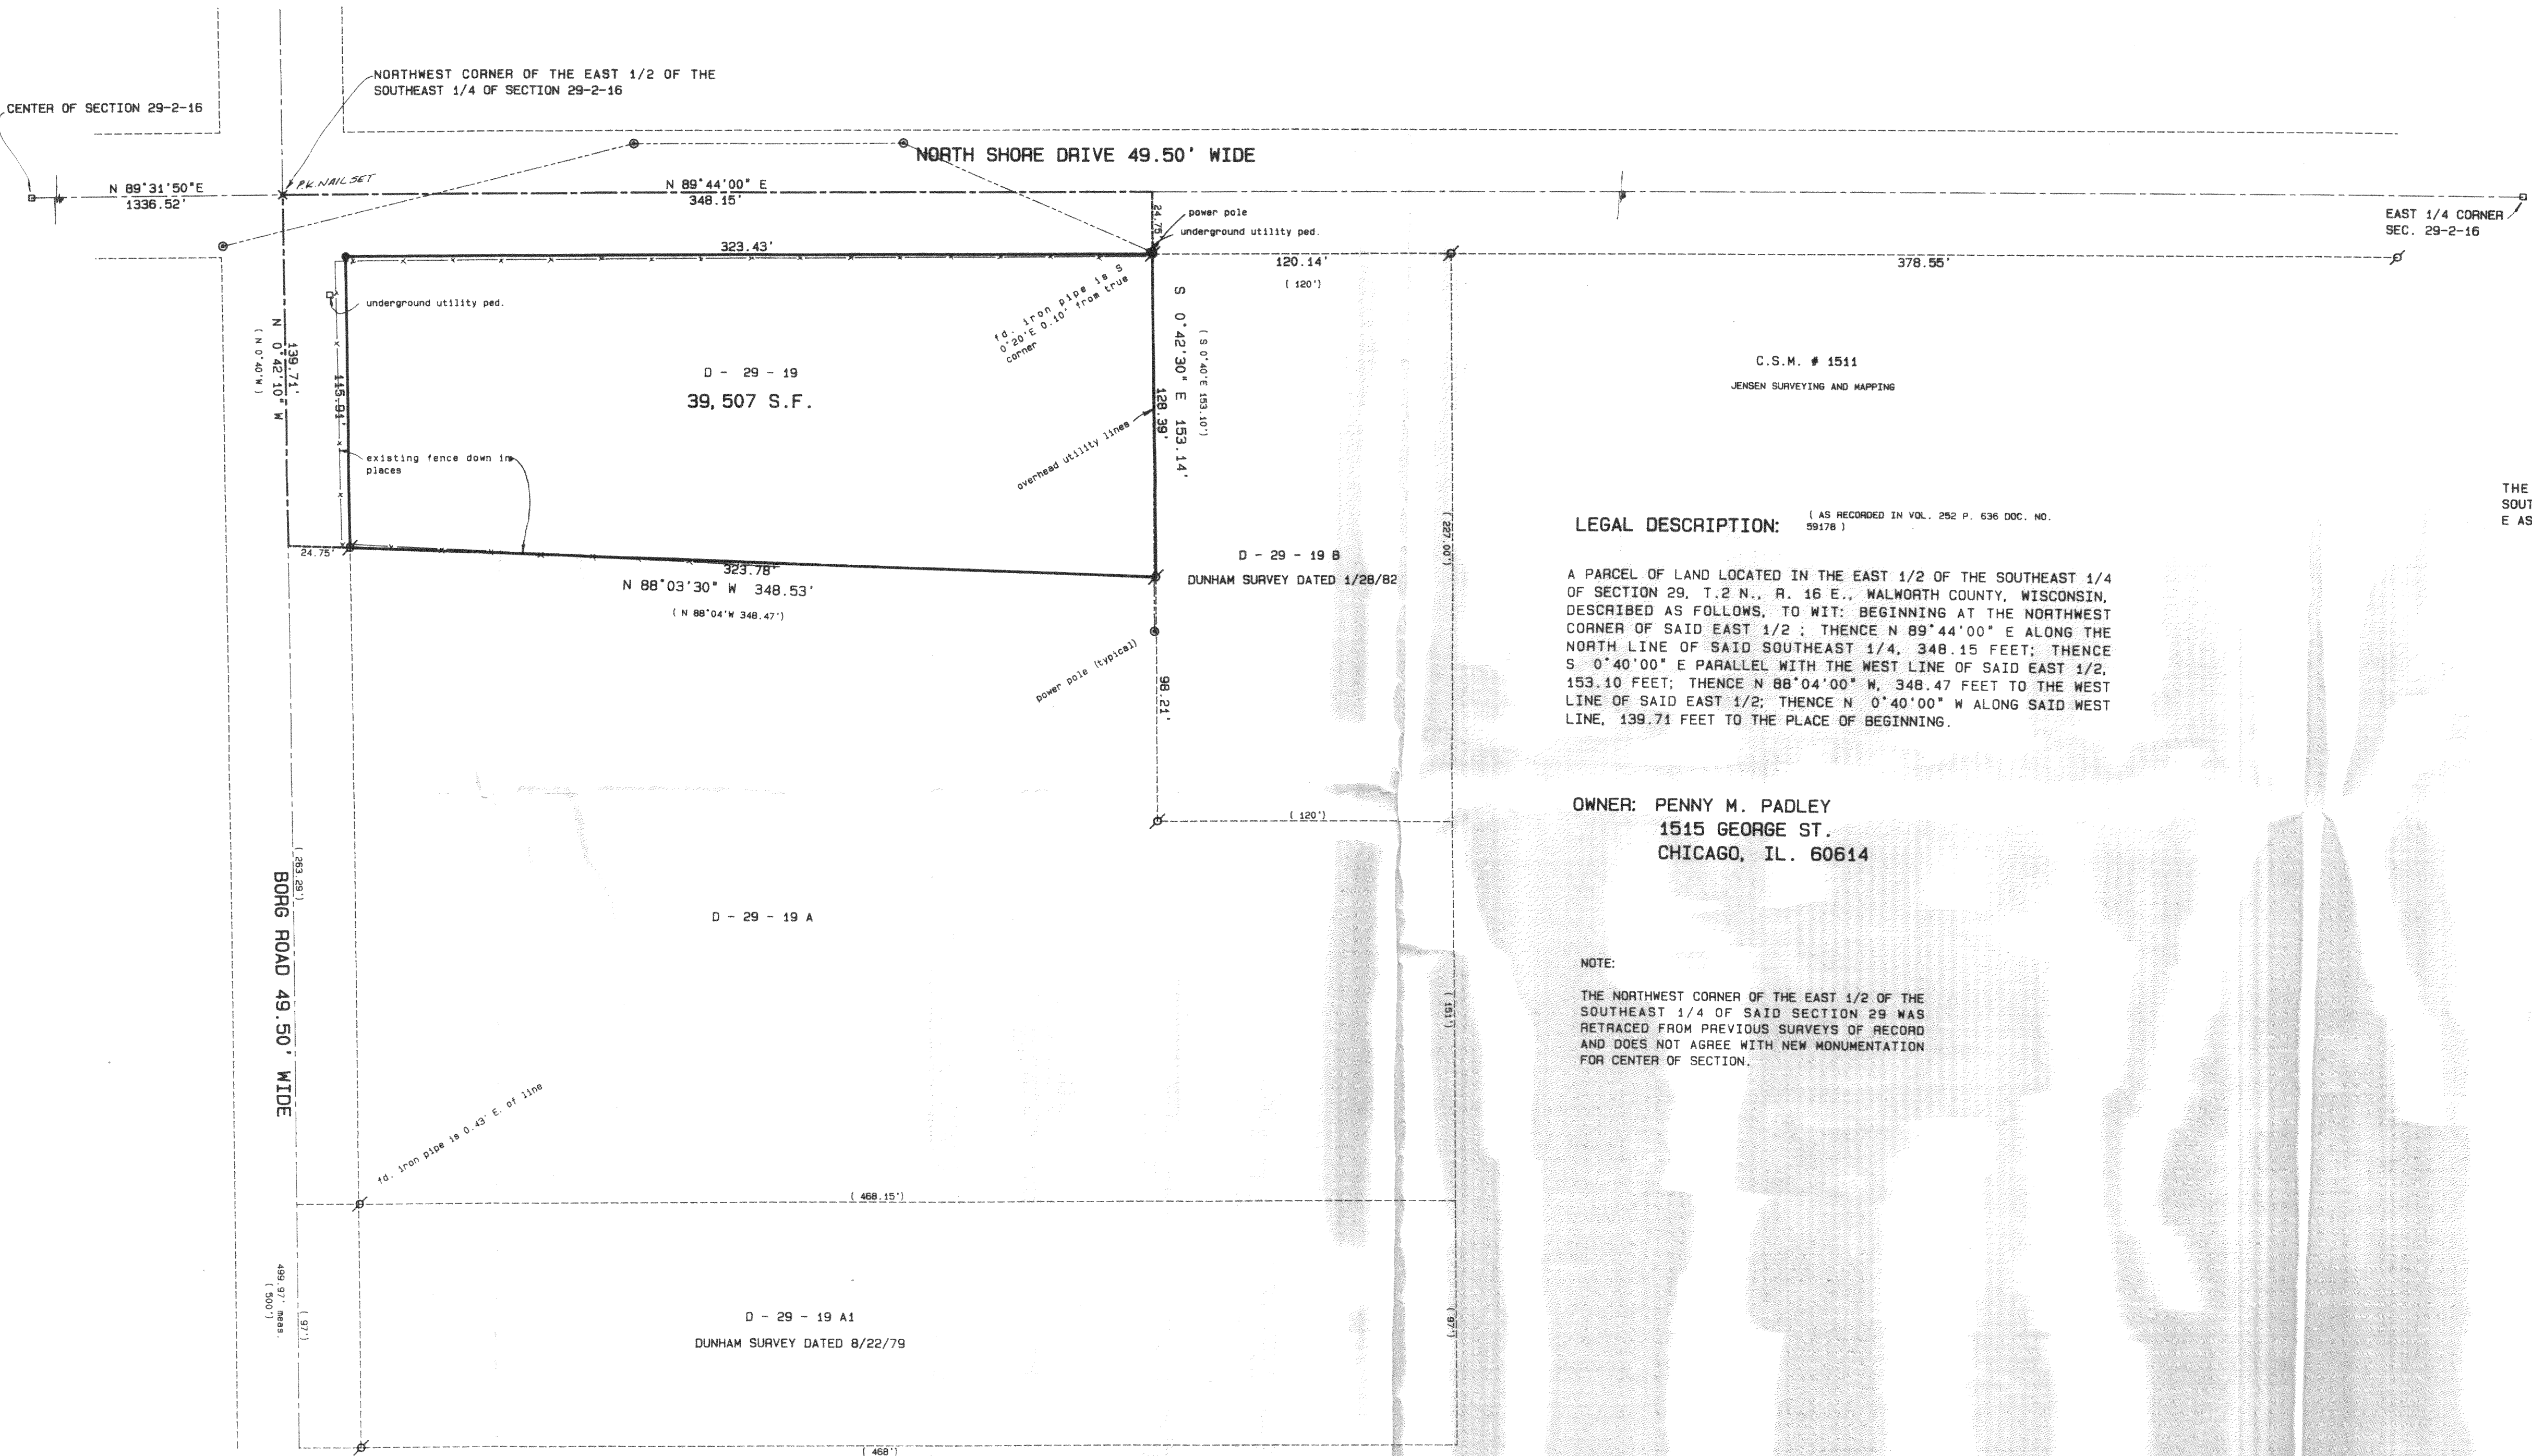

LEGAL DESCRIPTION:

A PARCEL OF LAND LOCATED IN THE EAST 1/2 OF THE SOUTHEAST 1/4 OF SECTION 29, T.2 N., R. 16 E., WALWORTH COUNTY, WISCONSIN, DESCRIBED AS FOLLOWS, TO WIT: BEGINNING AT THE NORTHWEST CORNER OF SAID EAST 1/2; THENCE N 89°44'00" E ALONG THE NORTH LINE OF SAID SOUTHEAST 1/4, 348.15 FEET; THENCE S 0°40'00" E PARALLEL WITH THE WEST LINE OF SAID EAST 1/2, 153.10 FEET; THENCE N 88°04'00" W, 348.47 FEET TO THE WEST LINE OF SAID EAST 1/2; THENCE N 0°40'00" W ALONG SAID WEST LINE, 139.71 FEET TO THE PLACE OF BEGINNING.


OWNER: PENNY M. PADLEY
1515 GEORGE ST.
CHICAGO, IL. 60614

NOTE:


THE NORTHWEST CORNER OF THE EAST 1/2 OF THE SOUTHEAST 1/4 OF SAID SECTION 29 WAS RETRACED FROM PREVIOUS SURVEYS OF RECORD AND DOES NOT AGREE WITH NEW MONUMENTATION FOR CENTER OF SECTION.

Legend

- FOUND IRON PIPE
- FOUND IRON ROD
- FOUND BRASS CAPPED MONUMENT
- CHISEL CUT IN CONCRETE
- SET IRON ROD, 24" LONG, REICHING 1.5 LBS. LINEAL FT., 3/4" DIA.
- SET IRON ROD, 30" LONG, REICHING 4.5 LBS. LINEAL FT., 1-11/16" DIA.
- RECORDED AS DIMENSION
- EXISTING FENCE

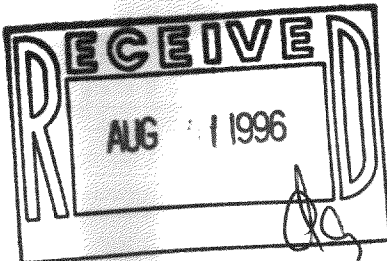

SCALE: 1" = 40 FEET

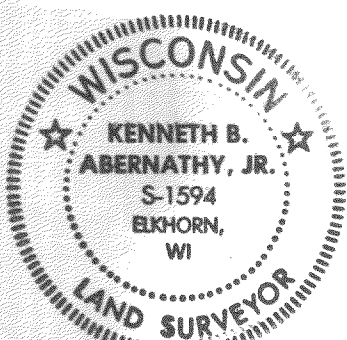

I hereby certify that the above described property has been surveyed by me or under my direction and that the above map is a true representation thereof and shows the size and location of the property, its exterior boundaries, the location of all visible structures and easements, roadways and visible encroachments, if any. This survey is made for the use of the present owners of the property, and also those who purchase, mortgage, or guarantee the title thereto within one year from date hereof.

Kenneth B. Abernathy, Jr.
WISCONSIN REGISTERED LAND SURVEYOR,
S-1594
Date: 7-24-96 Job No. 96-707

FD-29-19
216-2340