

ABELL
SURVEYING & MAPPING

1140 SEQUOIA STREET • DELAVAN, WISCONSIN 53115
414-728-6737


OAK STREET
(IRVING AVENUE)
20 FEET WIDE

LOT 41

ORDERED BY: FLANDO & McCLAIN
ATTORNEYS AT LAW
638 PINTAIL
DEERFIELD, IL 60045

LOT 42

LOT 43

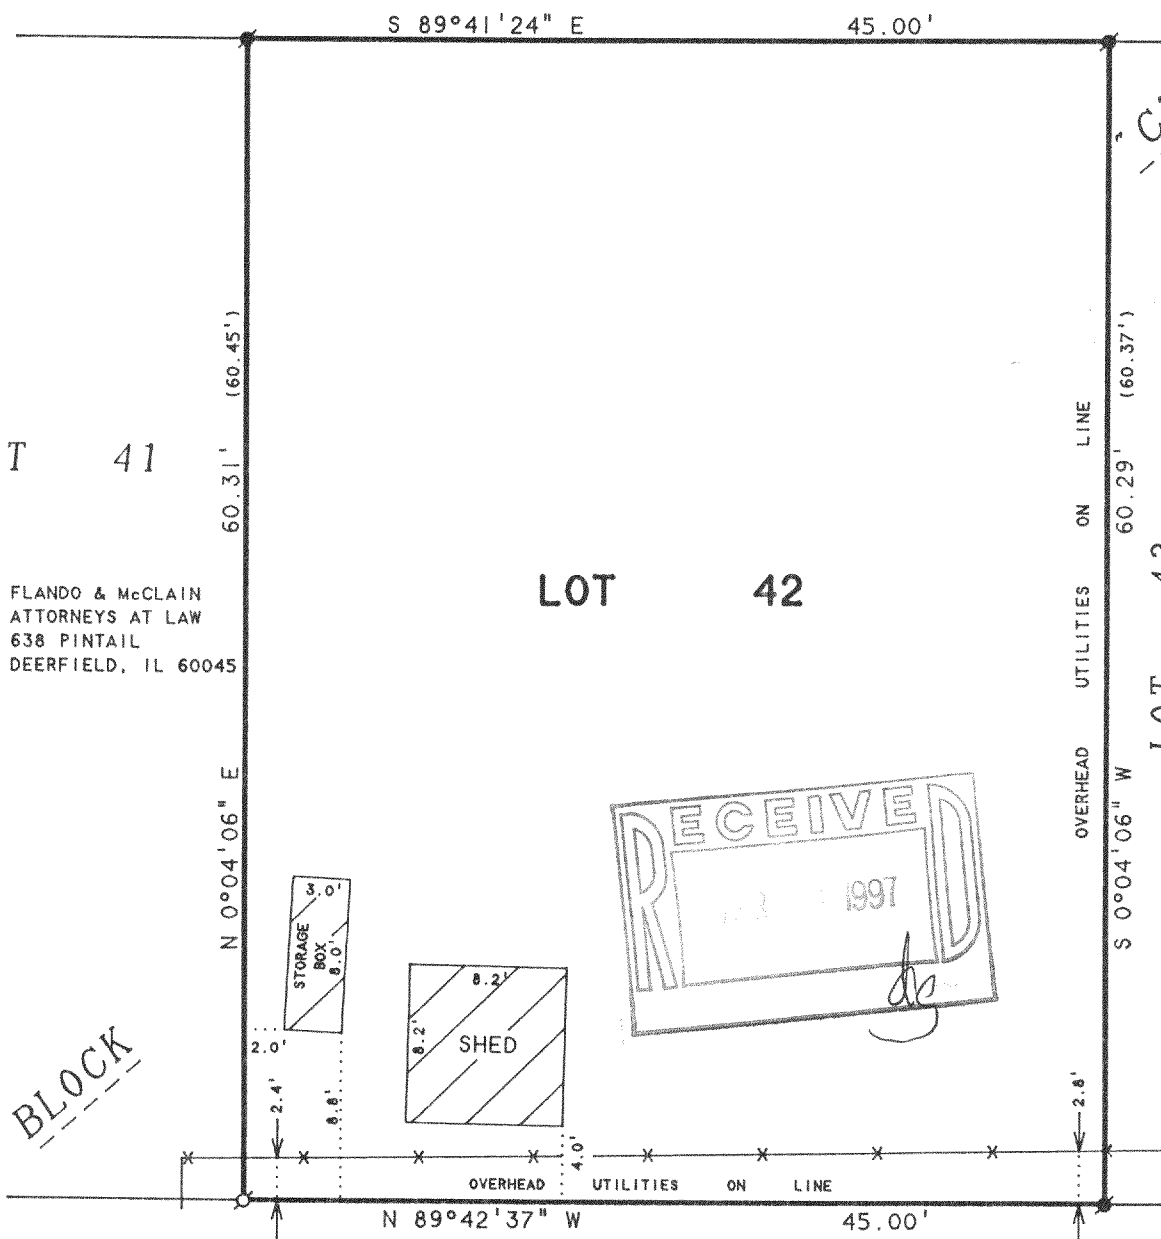

NOTE: BEARINGS ARE REFERENCED TO
EXISTING SURVEY RECORDS.

PLAT OF SURVEY OF

LOT 42, BLOCK "C", DELAVAN LAKE
ASSEMBLY GROUNDS, LOCATED IN T2N.
R16E, WALWORTH COUNTY, WISCONSIN.

N



SCALE 1"=10'

LEGEND

- -IRON PIPE FOUND
- -IRON ROD FOUND
- X—X— -WOOD FENCE
- () -RECORDED AS

I HEREBY CERTIFY THAT I HAVE SURVEYED THE ABOVE DESCRIBED PROPERTY AND THAT THE ABOVE MAP IS A TRUE REPRESENTATION THEREOF AND SHOWS THE SIZE AND LOCATION OF THE PROPERTY, ITS EXTERIOR BOUNDARIES, THE LOCATION OF ALL VISIBLE STRUCTURES AND DIMENSIONS OF ALL PRINCIPAL BUILDINGS THEREON, BOUNDARY FENCES, APPARENT EASEMENTS, ROADWAYS AND VISIBLE ENCROACHMENTS, IF ANY, TO THE BEST OF MY KNOWLEDGE AND BELIEF.

THIS SURVEY IS MADE FOR THE USE OF THE PRESENT OWNERS OF THE PROPERTY, AND ALSO THOSE WHO PURCHASE, MORTGAGE, OR GUARANTEE THE TITLE THERETO WITHIN ONE (1) YEAR FROM DATE HEREON.

David F. Abell

DAVID F. ABELL
WISCONSIN REGISTERED LAND SURVEYOR, S-1596

March 3, 1997

DATE JOB NUMBER - 97034
NOTE: THIS IS NOT A CERTIFIED COPY UNLESS SEALED.

FDLA-440 216-2457