ABELL

SURVEYING & MAPPING

DELAVAN, WISCONSIN 53115 414-728-6737

PLAT OF SURVEY OF

LOT 284 OF LAKE DELAVAN HIGHLANDS, LOCATED IN SECTION 31, T2N, R16E, WALWORTH COUNTY, WISCONSIN.

ORDERED BY: CENTURY 21 - SKANDIA REALTY

312 S. 7th STREET DELAVAN, WI. 53115

REVISED: NOVEMBER 7, 1995


ORDERED BY: LAKE GENEVA PROPERTIES

816 WILLIAMS ST.

LAKE GENEVA, WI 53147

REVISED MARCH 20, 1997 TO SHOW PROPOSED ADDITIONS TO THE HOUSE ORDERED BY: JOE ROZNER

SOUTH

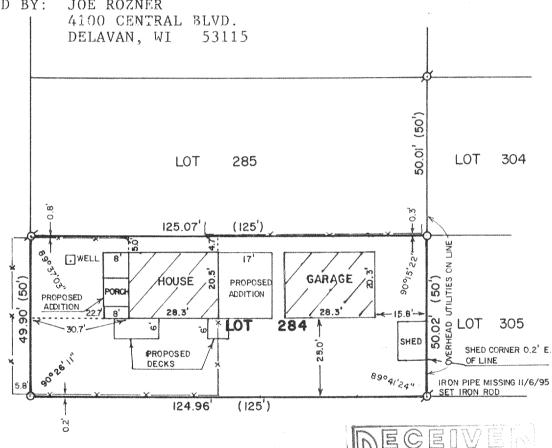

SCALE - 1"=30'

LEGEND

Ø - IRON PIPE FOUND

O - IRON ROD SET, FOUND 11/6/95

()- RECORDED AS

60.00

×--- WOOD FENCE

I, DAVID F. ABELL, DO HEREBY CERTIFY THAT I HAVE SURVEYED THE PROPERTY HEREON DESCRIBED ACCORDING TO THE OFFICIAL RECORDS AND THAT THE PLAT HEREON IS A CORRECT REPRESENTATION OF THE PROPERTY LINES TO THE BEST OF MY KNOWLEDGE AND BELIEF.

DRIVE

SHORE

DAVID F. ABELL WISCONSIN REGISTERED LAND SURVEYOR, S-1596

1987 REVISED: 11/7/95

JOB NUMBER - 87193

NOTE: THIS IS NOT A CERTIFIED COPY UNLESS SEALED.

216-2458 FLAD-216