


GEORGE T. DUNHAM
SURVEYING & SUBDIVIDING
DELAVAN, WISCONSIN

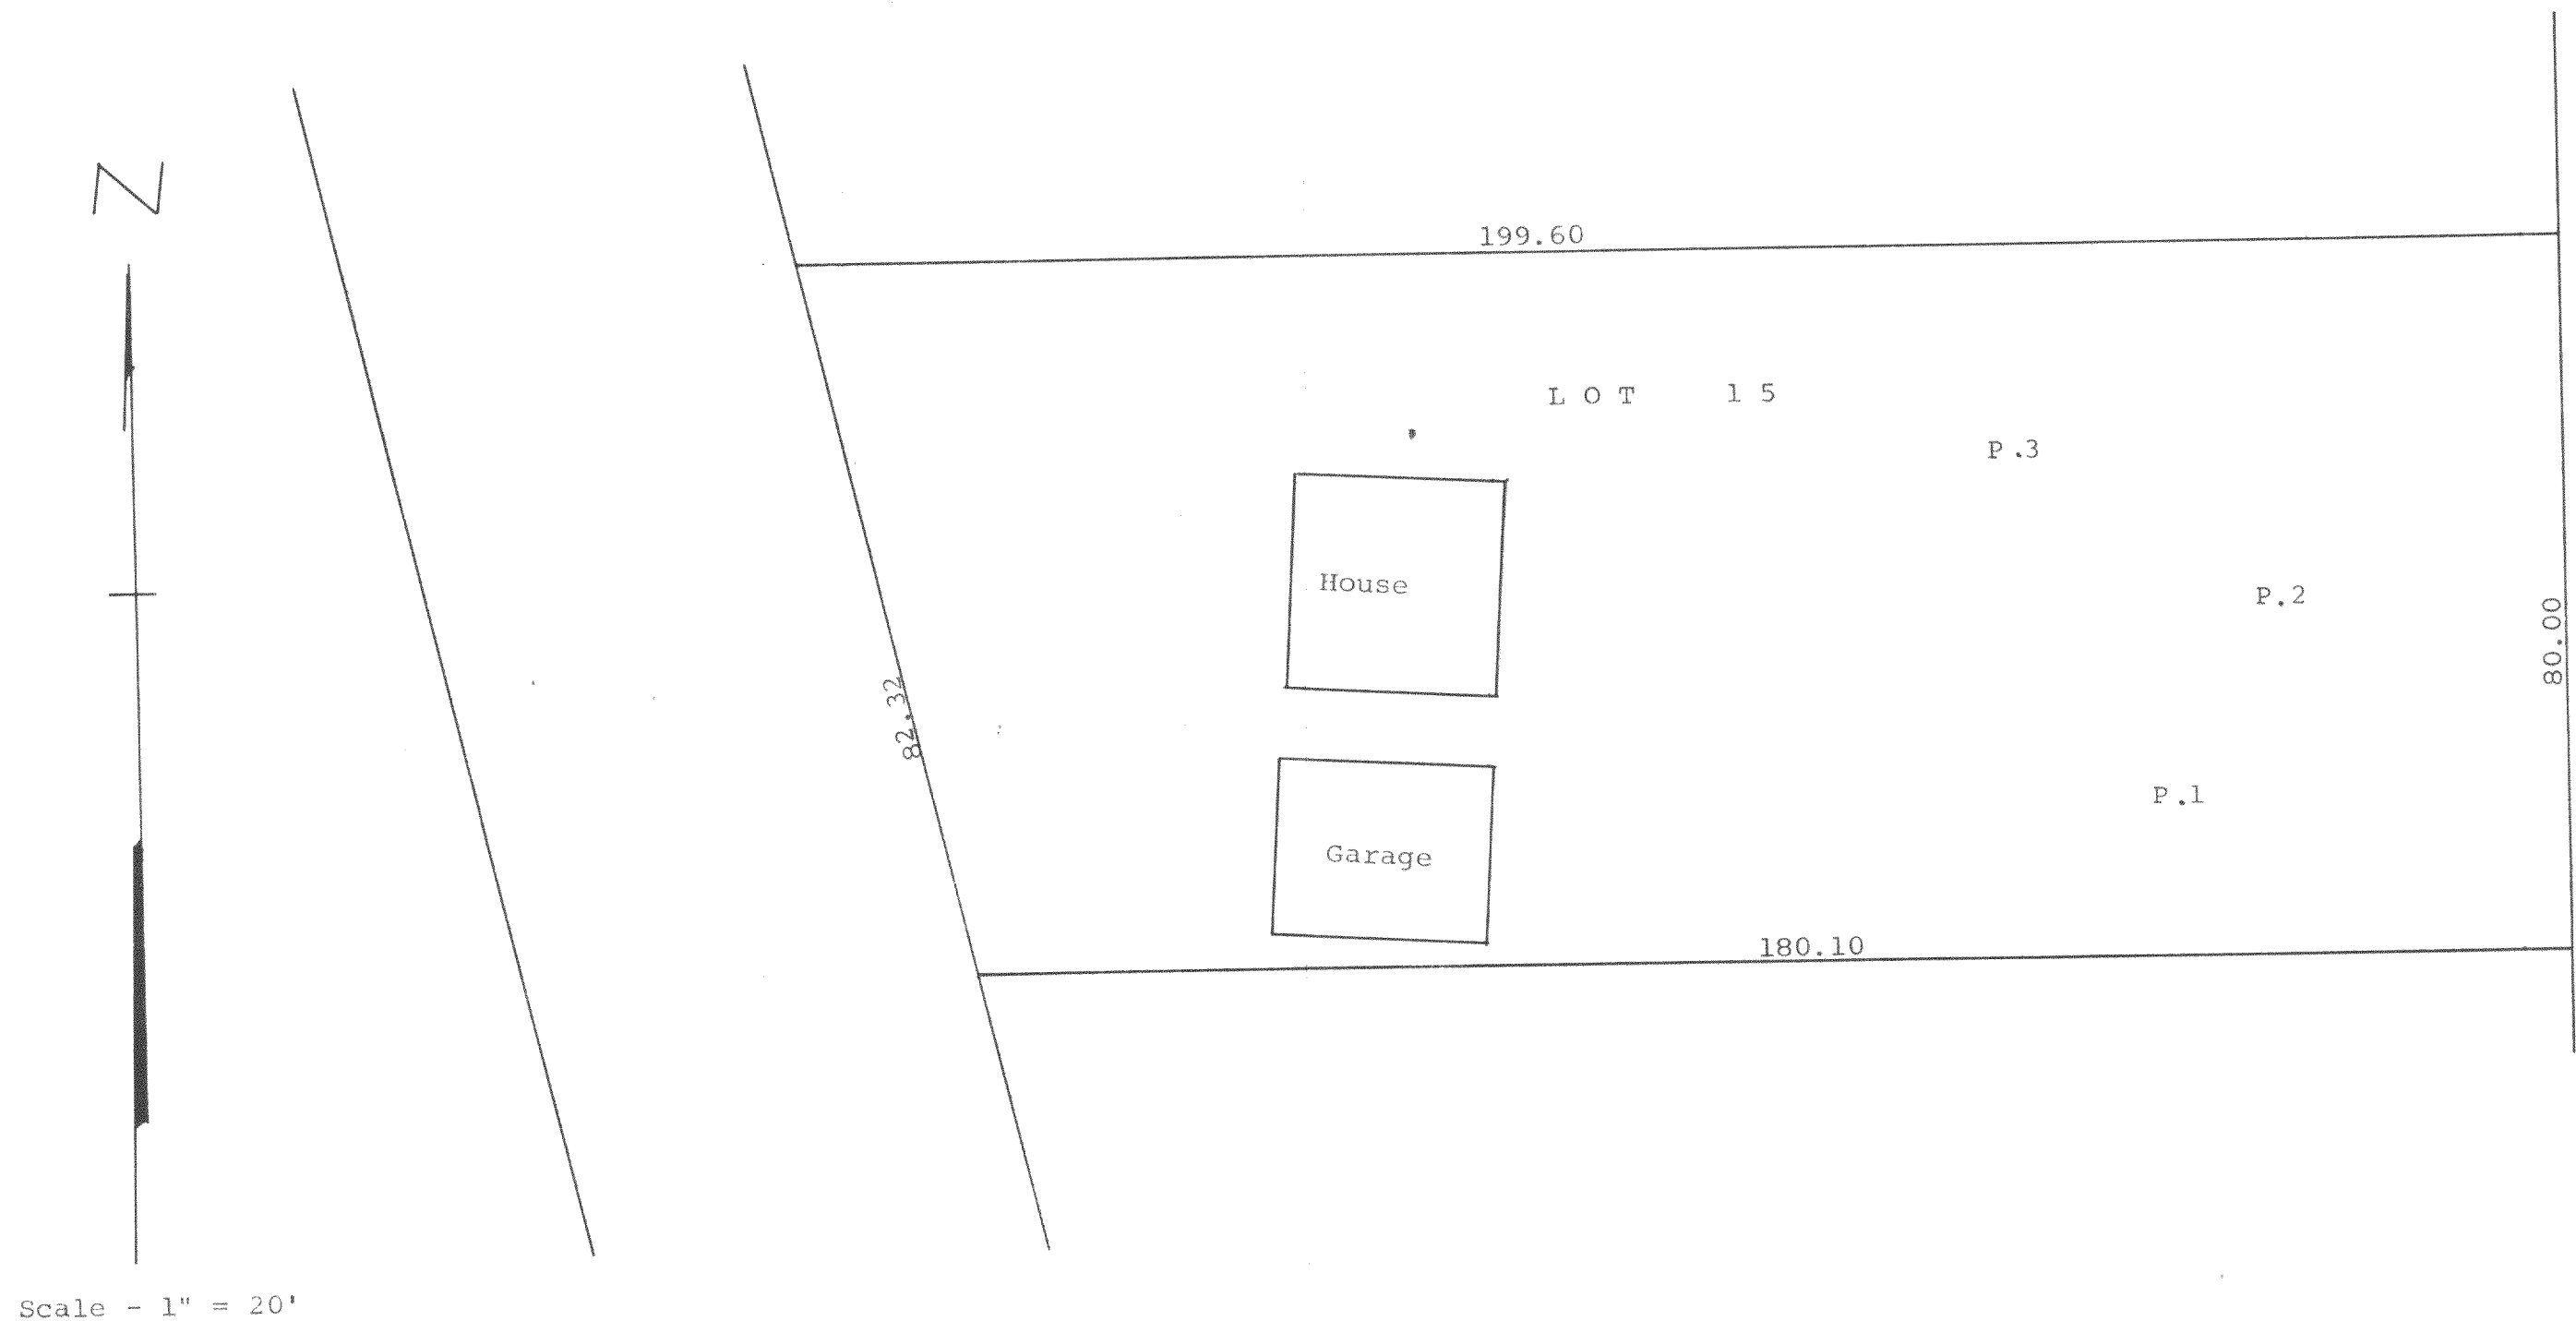

Scale - 1" = 20'

Plat showing the location of the percolation tests on
Lot 15, Block 7, Delmar Subdivision, Town of Delavan,
Walworth County, Wisconsin.
July 12, 1967

George T. Dunham
George T. Dunham, Surveyor

FDM-36C

216-246