


PLAT OF SURVEY

LOT 5 AND THE NORTHEASTERLY 44 FEET OF LOT 6 OF COLLIE'S GROVE SUBDIVISION
LOCATED IN THE NORTHWEST 1/4 OF SECTION 33, TOWN 2 NORTH, RANGE 16 EAST,
TOWN OF DELAVAN, WALWORTH COUNTY, WISCONSIN.


OWNED BY: JOHN & GLORIA DWINNELL
3409 S. SHORE DRIVE
DELAVAN, WIS. 53115

ORDERED BY: KIM DEVINCENTIS
RE/MAX LAKES AREA REALTORS
1815 NORTH SHORE DRIVE
DELAVAN, WI. 53115

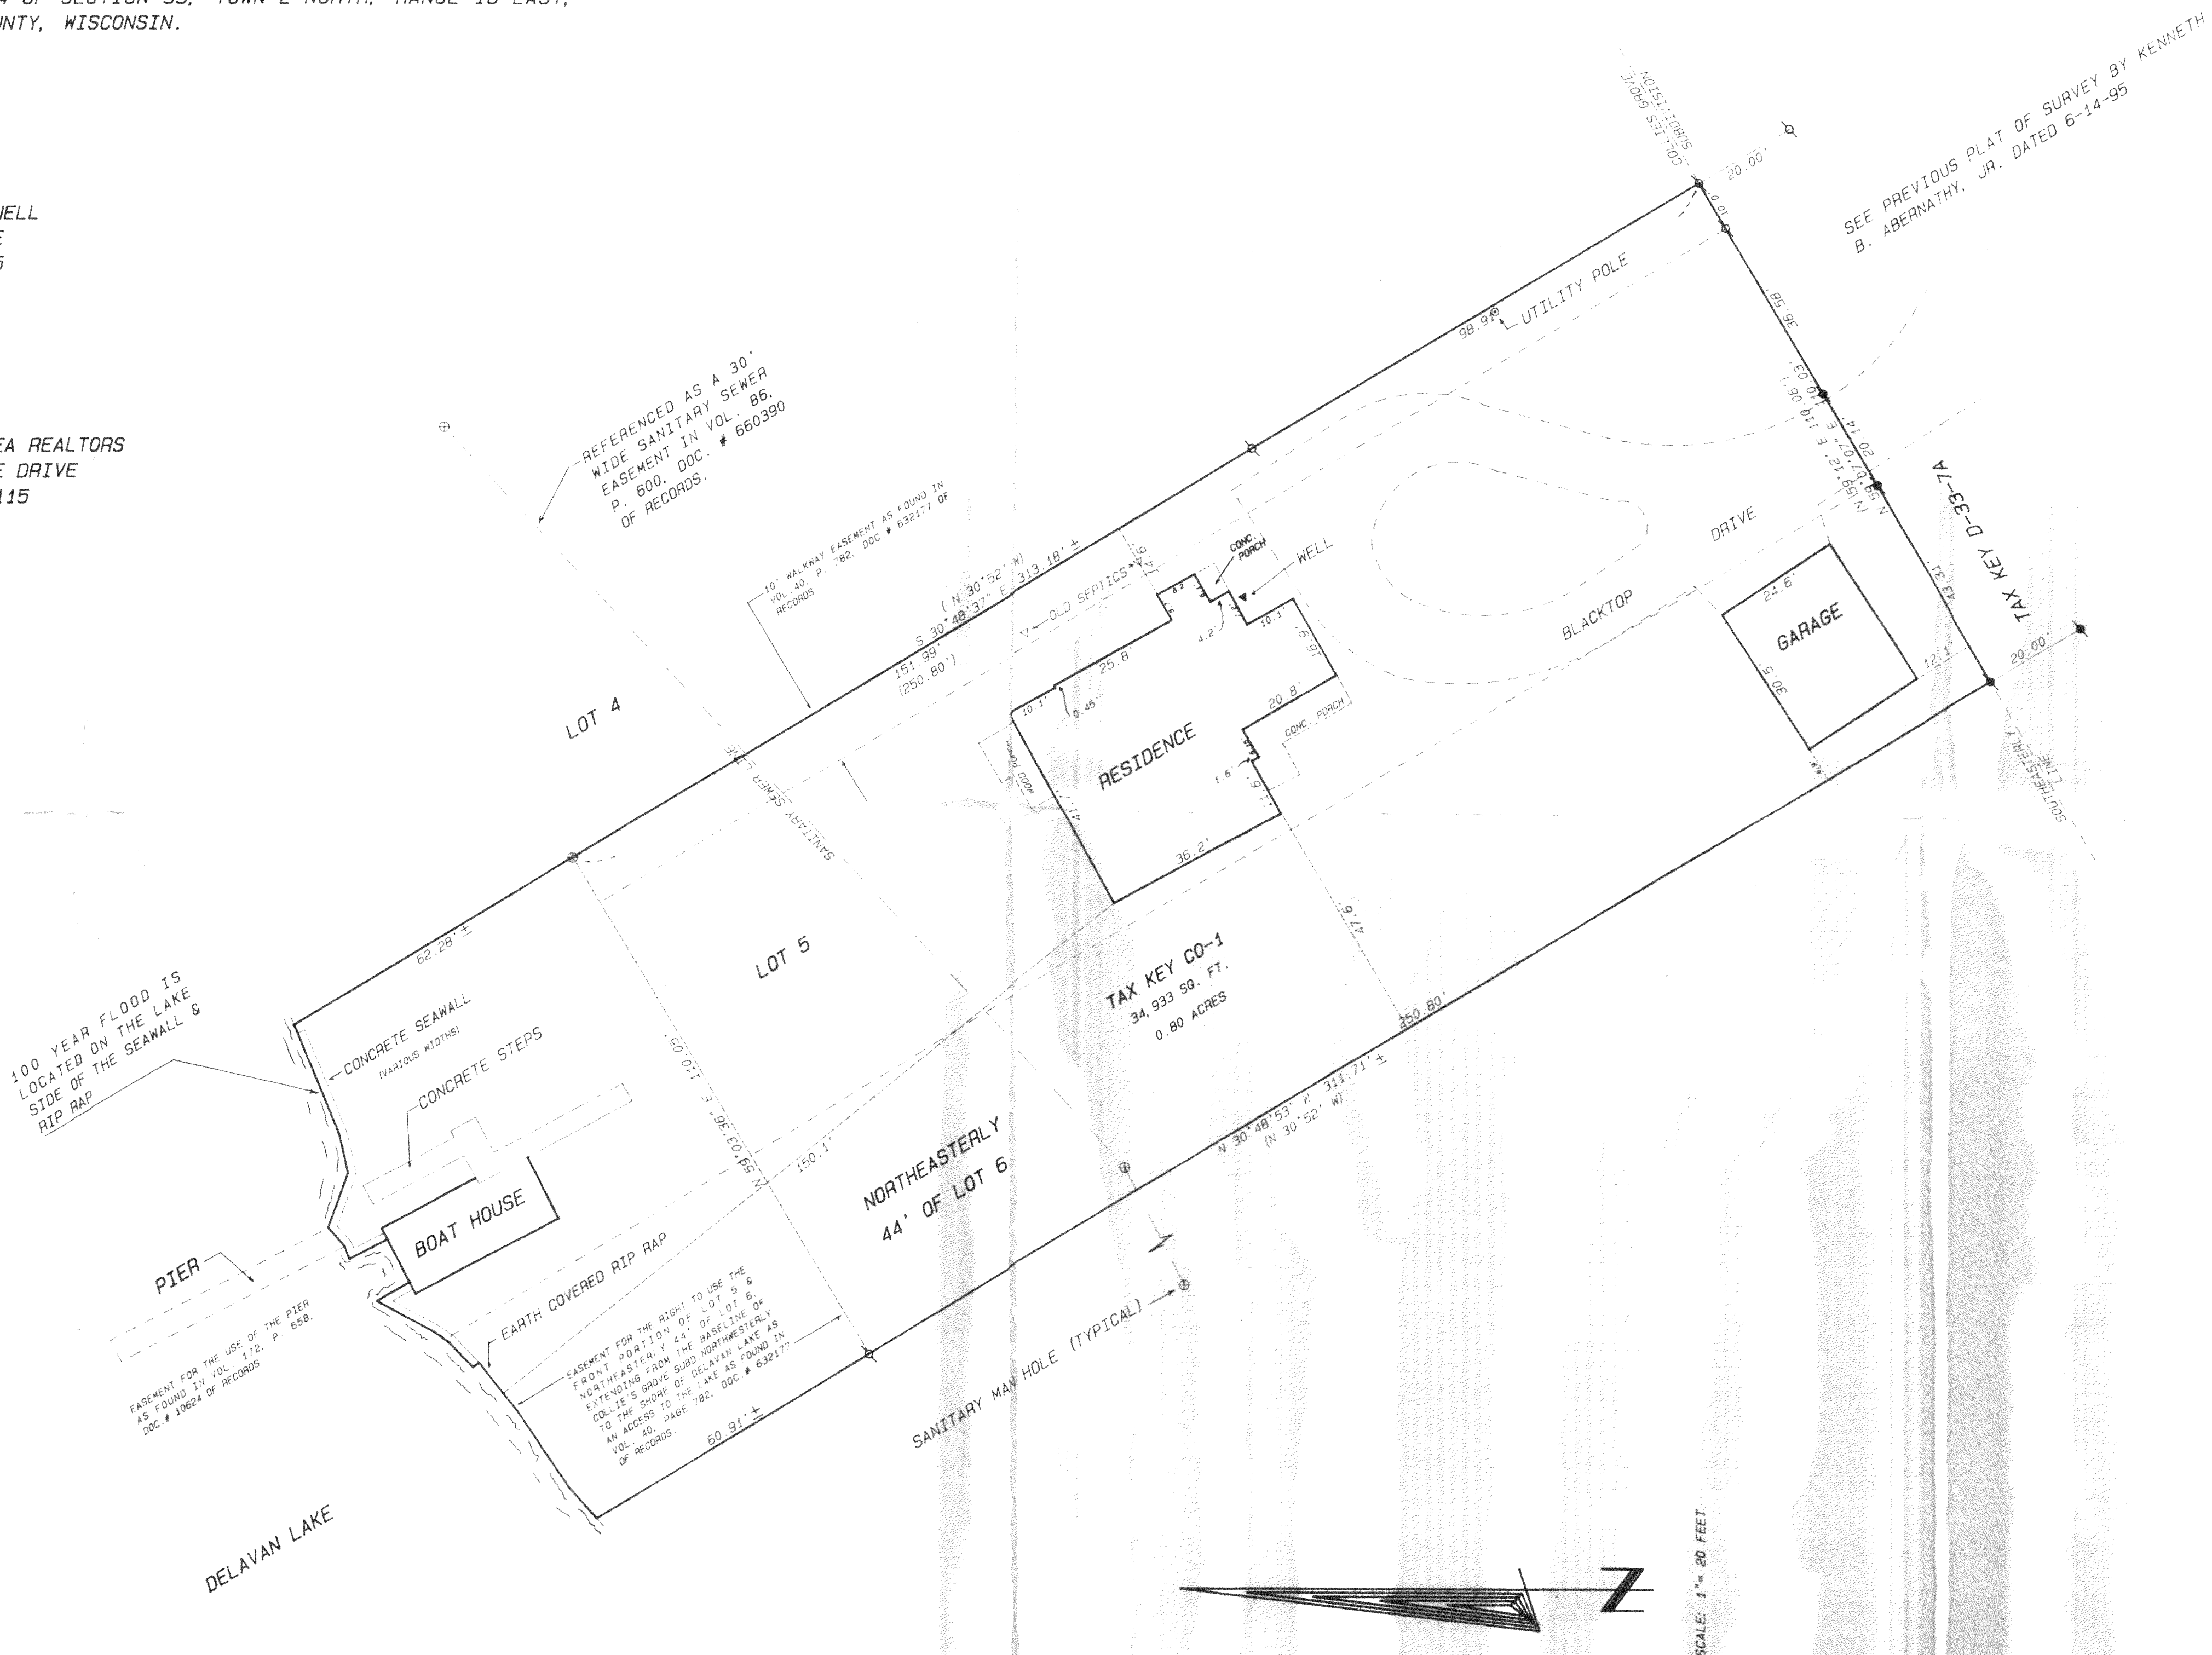

Legend

- FOUND IRON PIPE
- FOUND IRON ROD
- FOUND BRASS CAPPED MONUMENT
- FOUND CONCRETE MONUMENT
- CHISEL CUT IN CONCRETE
- SET IRON ROD 24" LONG, WEIGHING 15 LBS. LINEAL FT. 1 1/4" DIA.
- SET IRON ROD 30" LONG, WEIGHING 15 LBS. LINEAL FT. 1 1/4" DIA.
- RECORDED AS DIMENSION
- EXISTING FENCE

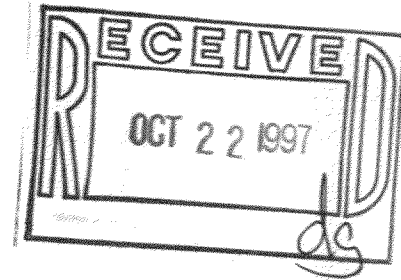

SCALE: 1" = 20 FEET



I hereby certify that the above described property has been surveyed by me or under my direction and that the above map is a true representation thereof and shows the size and location of the property, its exterior boundaries, the location of all visible structures and dimensions of all principal buildings thereon, boundary lines, easements, roadways and visible encroachments, if any.

This survey is made for the use of the present owners of the property and their heirs, assigns, mortgagees or guarantors for the term of years and their heirs, assigns, mortgagees or guarantors for the term of years.

Kenneth B. Abernathy, Jr.
WISCONSIN REGISTERED LAND SURVEYOR,
S-1594

Date: 10-20-97 Job No. 223013

216-2515
Fco-1