


PLAT OF SURVEY

LOT 2 OF SUMMIT MEADOWS
SUBDIVISION, LOCATED IN THE NW
1/4 OF THE NW 1/4 OF SECTION 31,
TOWN 2 NORTH, RANGE 16 EAST, TOWN
OF DELAVAN, WALWORTH COUNTY,
WISCONSIN.


ORDERED BY: SCHAUDER BUILDING, INC.
4115 HIGHWAY 51 NORTH
JANESVILLE, WISCONSIN
53545-9674



SCALE: 1" = 20 FEET

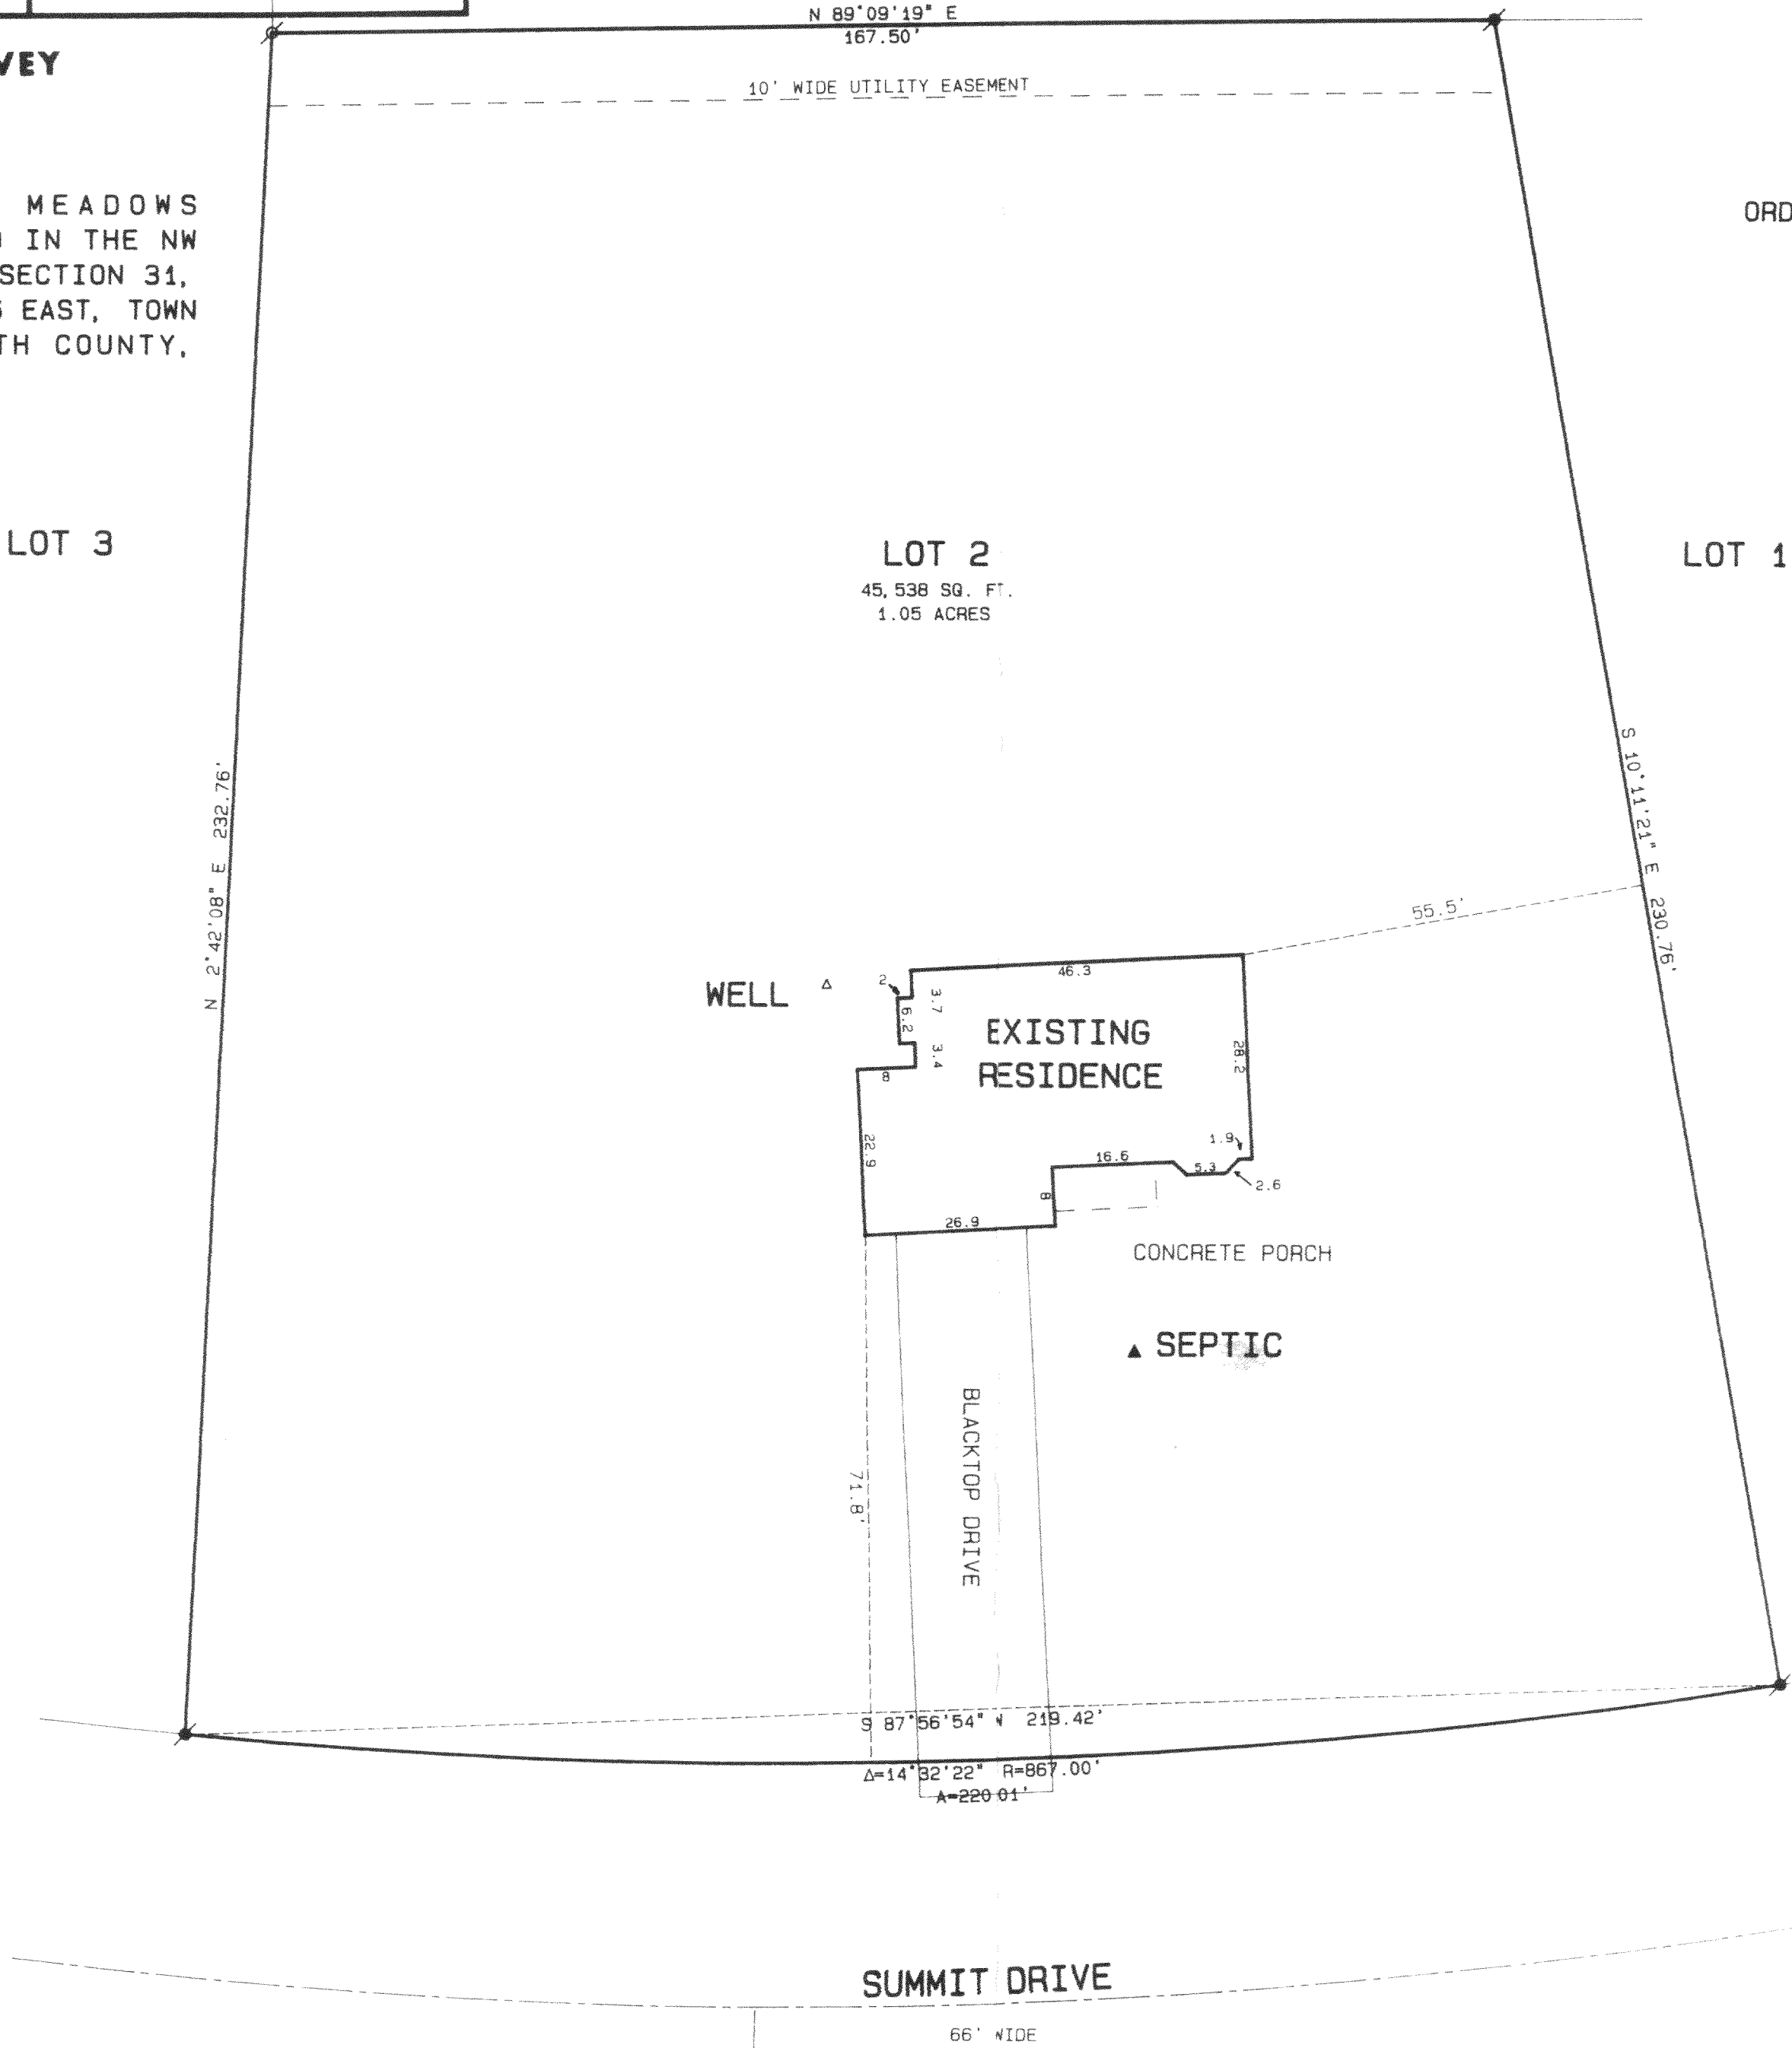


- Legend
- FOUND IRON PIPE
 - FOUND IRON ROD
 - FOUND BRASS CAPPED MONUMENT
 - ✱ FOUND CONCRETE MONUMENT
 - ✱ CHISEL CUT IN CONCRETE
 - SET IRON ROD, 24" LONG, WEIGHING 1.5 LBS. LINEAL FT., 3/4" DIA.
 - SET IRON ROD, 30" LONG, WEIGHING 4.5 LBS. LINEAL FT., 1 1/8" DIA.
 - RECORDED AS DIMENSION
 - - - - - EXISTING FENCE

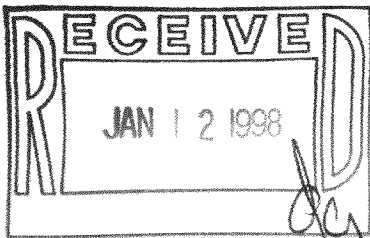

SCALE: 1" = 20 FEET

I, the undersigned, hereby certify that the above described property has been surveyed by me, or under my direction, and that the above map is a true and correct representation of the same, and shows the size and location of the property, its extent, boundaries, the location of all existing structures and dimensions of all improvements thereon, boundary lines, easements, rights-of-way, and all other matters affecting the same, and I guarantee the same to be true and correct for the use of the present owners of the property, and also those who purchase, mortgage, or guarantee the title thereto within one year from date hereof.

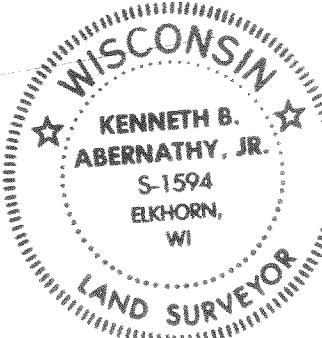

Kenneth B. Abernathy, Jr.
KENNETH B. ABERNATHY, JR.
WISCONSIN REGISTERED LAND SURVEYOR
S-1594
Date 11-26-97 Job No. 97.1107

216-2518
FSM-2