
ABELL SURVEYING & MAPPING

1140 SEQUOIA STREET • DELAVAN, WISCONSIN 53115 414-728-6737

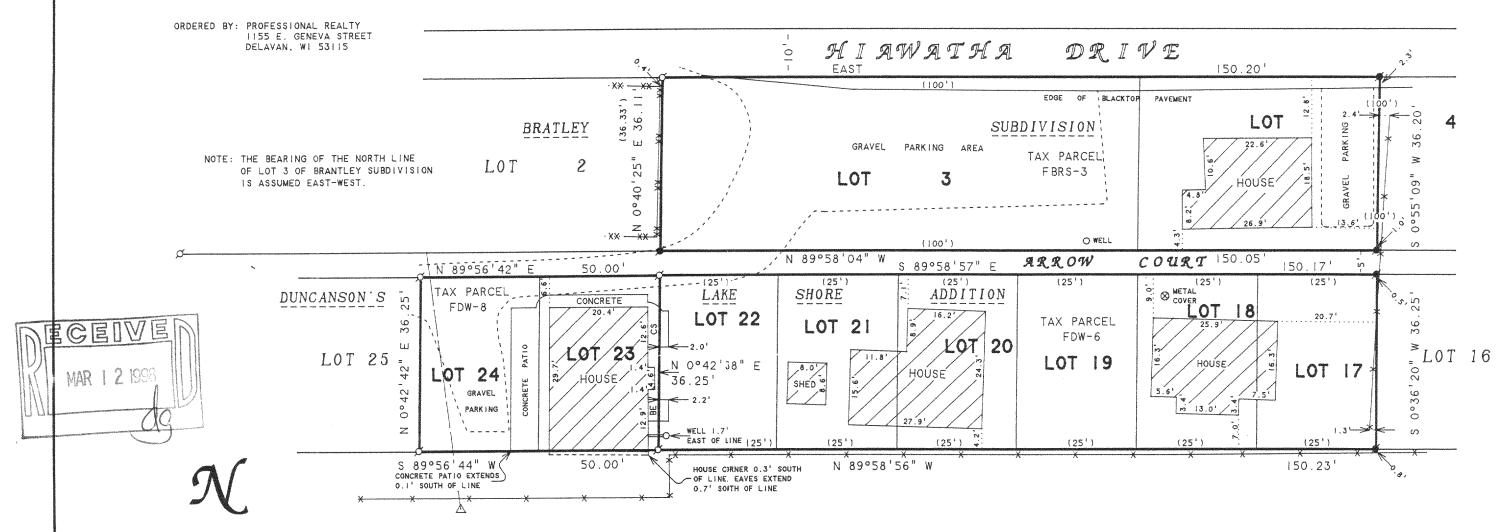

SCALE | "=20'
LEGEND

Ø -IRON PIPE FOUND

Ø -IRON ROD FOUND

BE -BASEMENT ENTRY

CS -CONCRETE STOOP

△ -UTILITY POLE

XX XX -WIRE FENCE ()-RECORDED AS

PLAT OF SURVEY OF

LOT 3 AND THE WEST 1/2 OF LOT 4 OF BRATLEY SUBDIVISION AND LOTS 17-24 OF DUNCANSON'S LAKE SHORE ADDITION, LOCATED IN T2N, R16E, WALWORTH COUNTY, WISCONSIN.

I HEREBY CERTIFY THAT I HAVE SURVEYED THE ABOVE DESCRIBED PROPERTY AND THAT THE ABOVE MAP IS A TRUE REPRESENTATION THEREOF AND SHOWS THE SIZE AND LOCATION OF THE PROPERTY, ITS EXTERIOR BOUNDARIES, THE LOCATION OF ALL VISIBLE STRUCTURES AND DIMENSIONS OF ALL PRINCIPAL BUILDINGS THEREON, BOUNDARY FENCES, APPARENT EASEMENTS, ROADWAYS AND VISIBLE ENCROACHMENTS, IF ANY. TO THE BEST OF MY KNOWLEDGE AND BELIEF.

THIS SURVEY IS MADE FOR THE USE OF THE PRESENT OWNERS OF THE PROPERTY, AND ALSO THOSE WHO PURCHASE, MORTGAGE, OR GUARANTEE THE TITLE THERETO WITHIN ONE (I) YEAR FROM DATE HEREON.

Xariel 7. alell

DAVID F. ABELL WISCONSIN REGISTERED LAND SURVEYOR, S-1596

November 14, 1997

DATE JOB NUMBER - 97190 NOTE: THIS IS NOT A CERTIFIED COPY UNLESS SEALED.

216-2531 FDW-6 FDW-8

FBRS -3