


# PLAT OF SURVEY

## LOT 2 OF CERTIFIED SURVEY MAP NO. 1098

LOCATED IN THE NW 1/4 OF SECTION 25, TOWN 2 NORTH,  
RANGE 16 EAST, WALWORTH COUNTY, WISCONSIN

JUL 14 1999

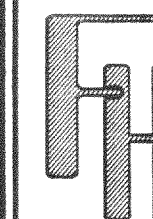

PLAT OF SURVEY

WORK ORDERED BY -  
KEVIN KIRKLAND  
THE LAKE GENEVA MARINE CO.  
P.O. BOX 487  
FONTANA, WI. 53125

FARRIS, HANSEN & ASSOCIATES, INC.  
Engineering, Architecture, Surveying  
7 Ridgway Court P.O. Box 437  
ELKHORN, WISCONSIN 53121  
Office: (414) 723-2098  
Fax: (414) 723-5886

REVISIONS

PROJECT NO.  
5294  
DATE  
06/04/99  
SHEET NO.  
1 OF 1

ASSIGNED S. LINE LOT 2 C.S.M. 1098  
N 89°59'15" W

NOTE: UNLESS OTHERWISE SHOWN ON THE PLAT,  
THE FENCE LINE SHOWN LIES WITHIN THE  
BOUNDARIES OF THE PARCEL SURVEYED.

LOT 1 C.S.M. 1098

LOT 2 C.S.M. 1098  
137,421 SQ. FT.  
(125,317 SQ. FT. LESS R.O.W.)

MAP SCALE IN FEET ORIGINAL 1" = 40'



NOTE: COPIES OF THIS MAP TO WHICH THE FOLLOWING CERTIFICATE  
WILL APPLY SHOW THE SURVEYOR'S ORIGINAL SEAL AND SIGNATURE  
IN RED INK. COPIES BY ANY OTHER MEANS MAY HAVE ALTERATIONS  
WHICH DO NOT REPRESENT THE SURVEYOR'S WORK PRODUCT.


I HEREBY CERTIFY THAT THE ABOVE DESCRIBED PROPERTY HAS BEEN  
SURVEYED UNDER MY DIRECTION AND THAT THE ABOVE MAP IS A TRUE  
REPRESENTATION THEREOF AND SHOWS THE SIZE AND LOCATION OF  
THE PROPERTY AND ITS EXTERIOR BOUNDARIES. THIS SURVEY IS  
MADE FOR THE USE OF THE PRESENT OWNERS OF THE PROPERTY, AND  
ALSO THOSE WHO PURCHASE, MORTGAGE, OR GUARANTEE THE TITLE  
THERE TO WITHIN ONE YEAR FROM THE DATE HEREOF.

DATED: 6/4/99

PETER S. GORDON R.L.S. 2101

### LEGEND

- = FOUND IRON PIPE STAKE
- = FOUND CONCRETE MONUMENT
- = UTILITY POLE LOCATED
- (xxx) = RECORDED AS

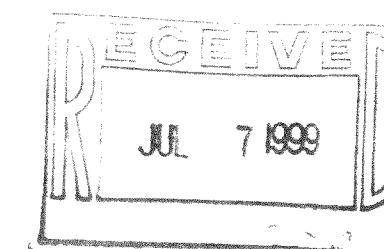

FA-1098-2

216-2736