


GEORGE T. DUNHAM
SURVEYING & SUBDIVIDING
DELAVER, WISCONSIN

Scale - 1" = 40'
○ = Iron Pipe
● = Concrete Monument

Plat of the survey of the SW'ly ½ of Lot 5, Lot 6,
Lot 7 and the NE'ly 25 feet of Lot 8 in Barnes and
Von Suessmilch Subdivision in Section 33, T 2 N,
R 16 E, Walworth County, Wisconsin.
March 28, 1969
Revised 4/4/69

George T. Dunham
George T. Dunham, Surveyor

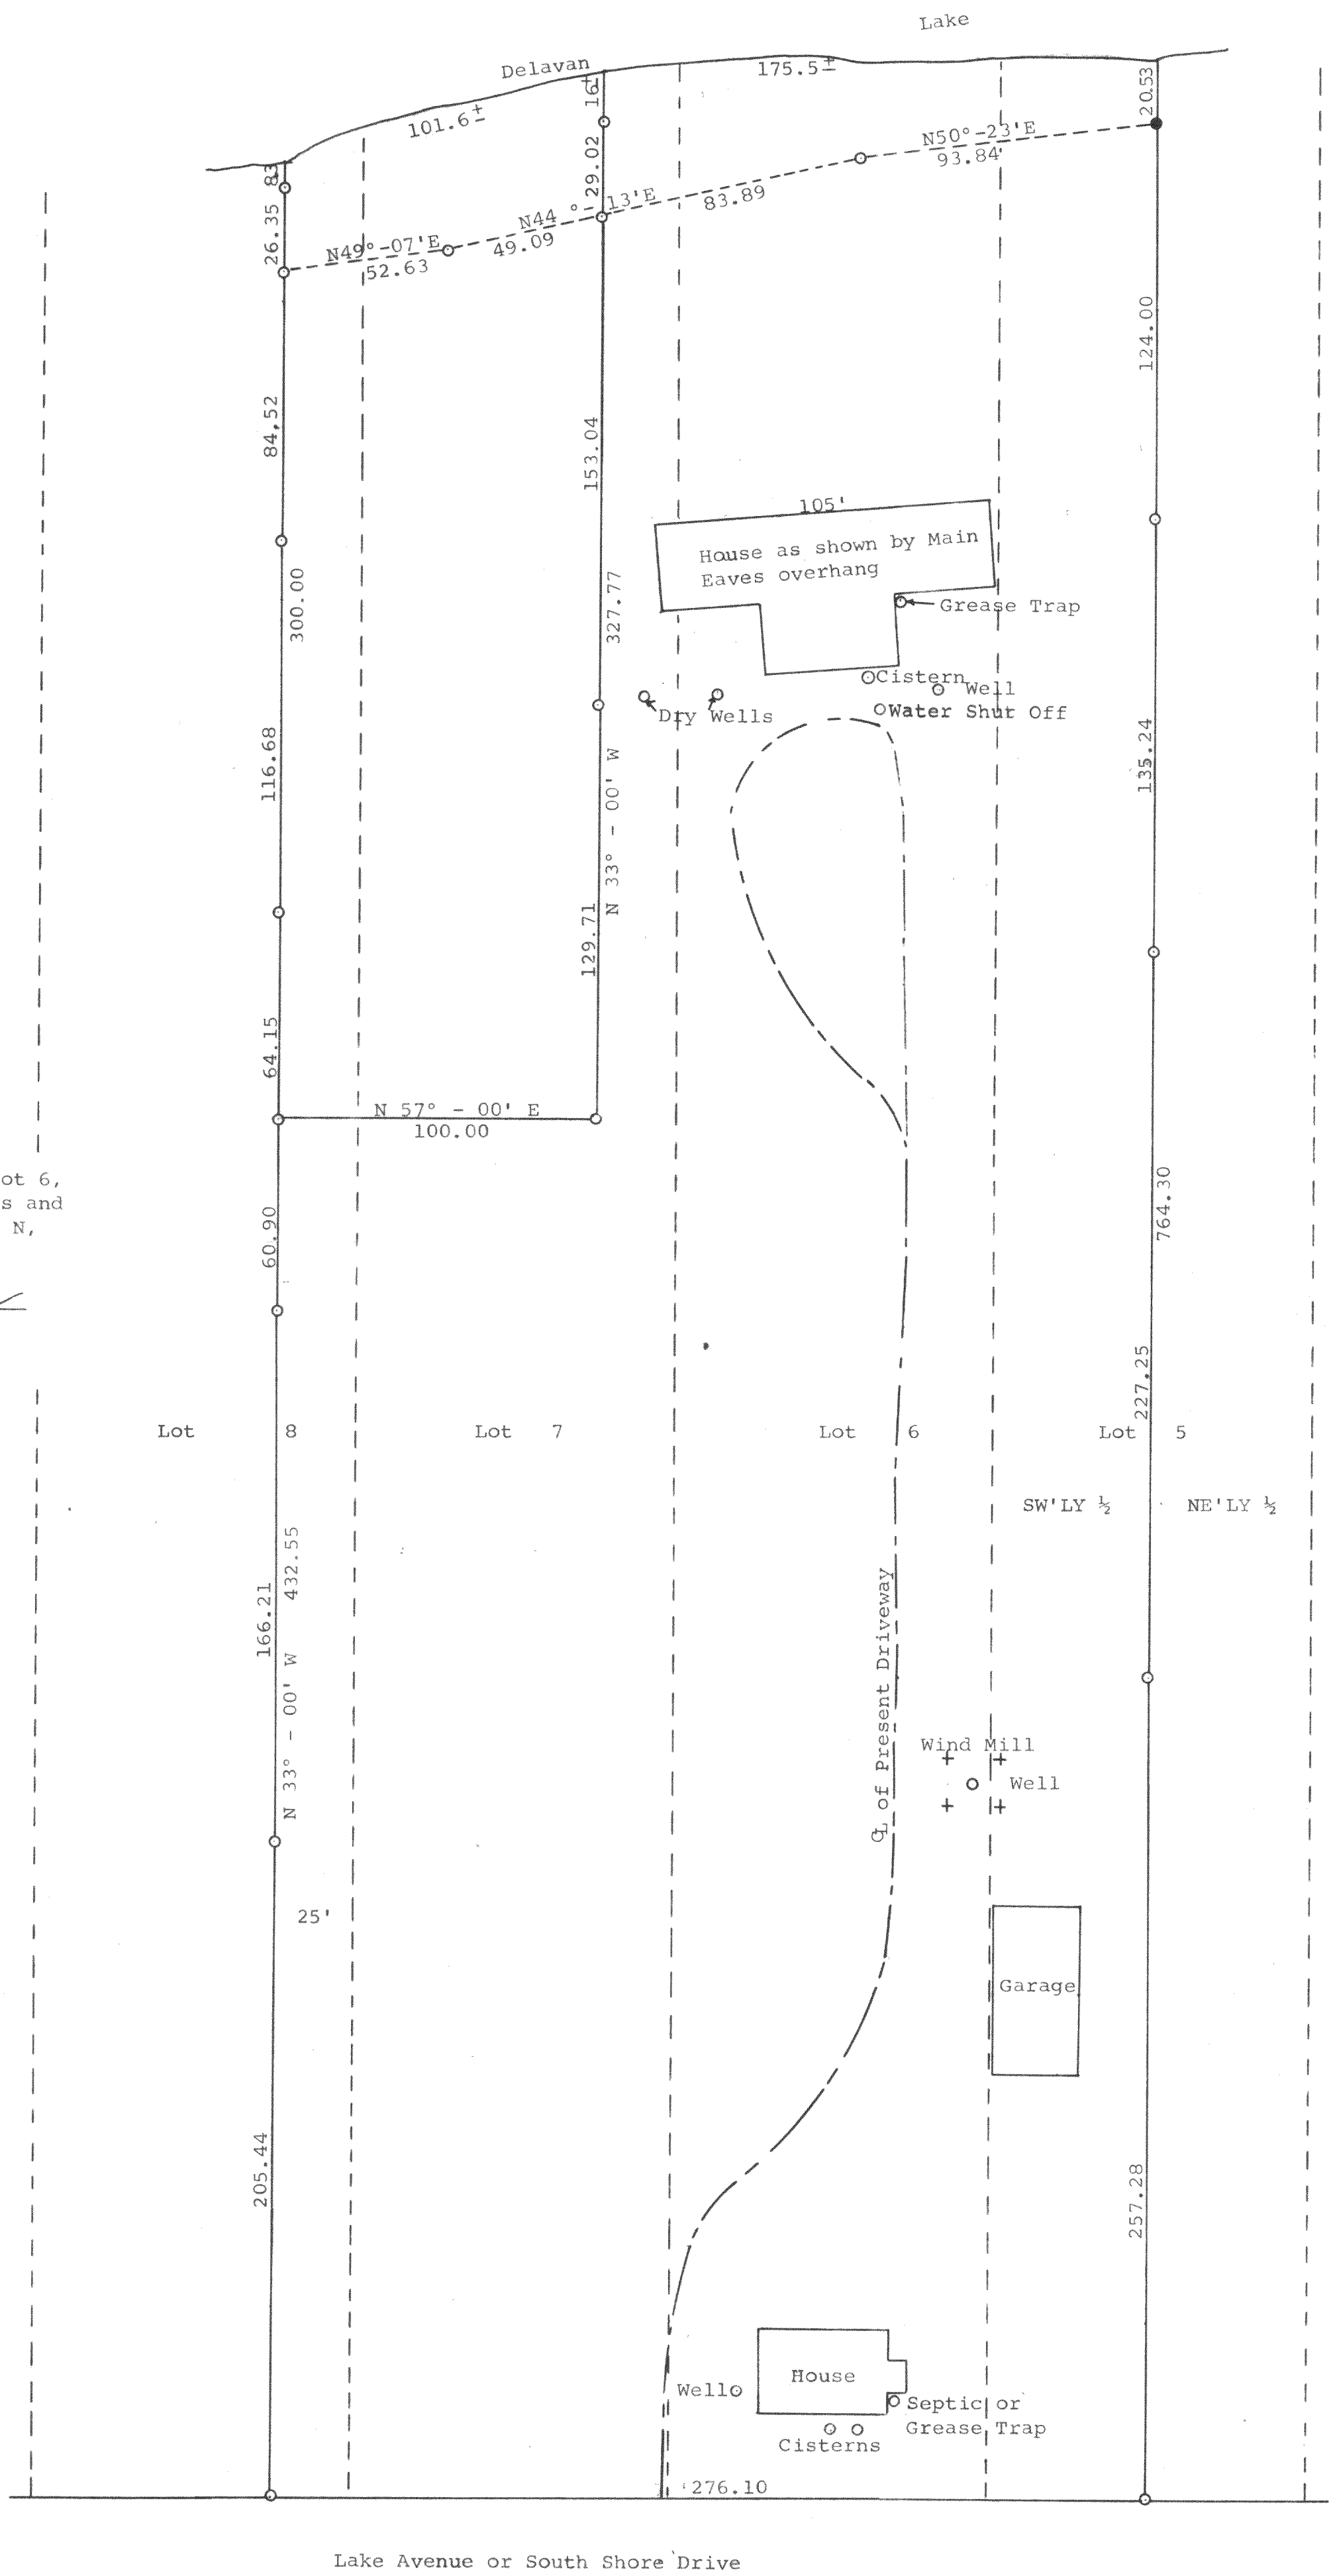

Lake Avenue or South Shore Drive

Rev. 6/1/69 399