

# THE TREE ROAD




LEGEND

- ♂ -IRON PIPE FOUND  
 ■ -CONCRETE MONUMENT FOUND  
 △ -UTILITY POLE  
 □ -UTILITY PED.  
 ( ) -RECORDED AS  
 X—X—X—WIRE FENCE

NOTE: BEARINGS ARE REFERENCED TO  
CERTIFIED SURVEY MAP NO. 1283.

OWNER: DENNIS KRUSZKA


LOT 1, CERTIFIED SURVEY MAP NO. 1283, LOCATED  
IN THE SOUTHWEST 1/4 OF THE SOUTHWEST 1/4 OF  
SECTION 25, T2N, R16E, WALWORTH COUNTY, WISCONSIN.

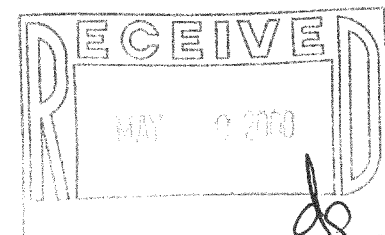

THIS SURVEY IS MADE FOR THE USE OF THE PRESENT OWNERS OF THE PROPERTY, AND ALSO THOSE WHO PURCHASE, MORTGAGE, OR GUARANTEE THE TITLE THERETO WITHIN ONE (1) YEAR FROM DATE HEREON.

September 21, 1993

DATE \_\_\_\_\_ JOB NUMBER - 93215  
NOTE: THIS IS NOT A CERTIFIED COPY UNLESS SEALED.

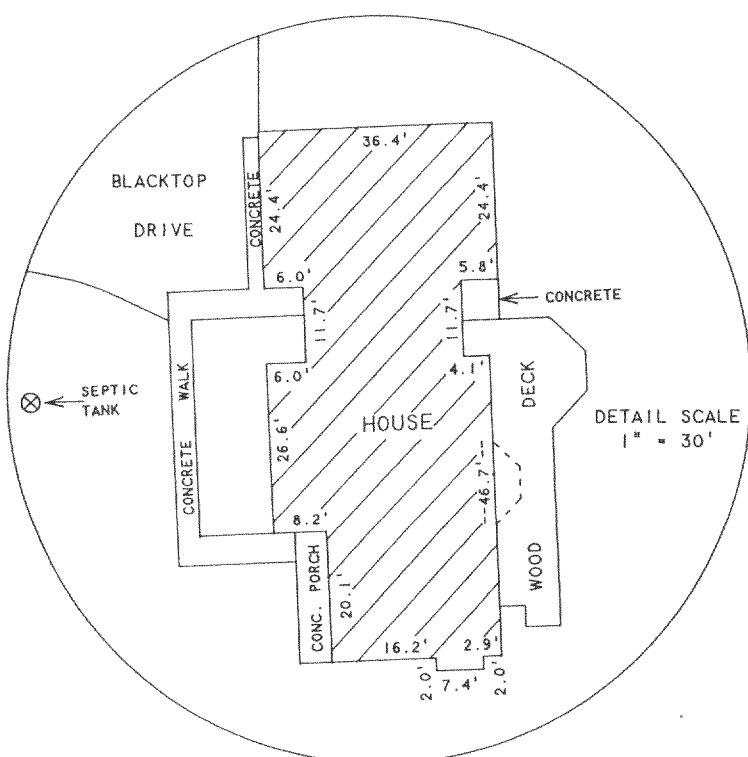

REVISED AND RECERTIFIED JANUARY 6, 2000  
ORDERED BY: THE RAULAND AGENCY  
P.O. BOX 159  
WALWORTH, WI 53184