


ABERNATHY and ASSOCIATES


Kenneth B. Abernathy Jr.

Wisconsin Registered Land Surveyor S-1594

Rt. 3, Box 273
Elkhorn, Wisconsin 53121
Phone: (414) 723-4260 (office)
(414) 723-4813 (residence)

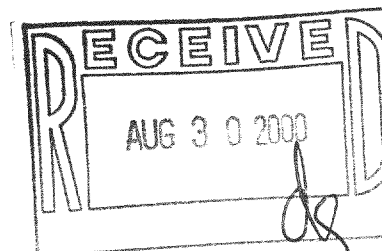

PLAT OF SURVEY

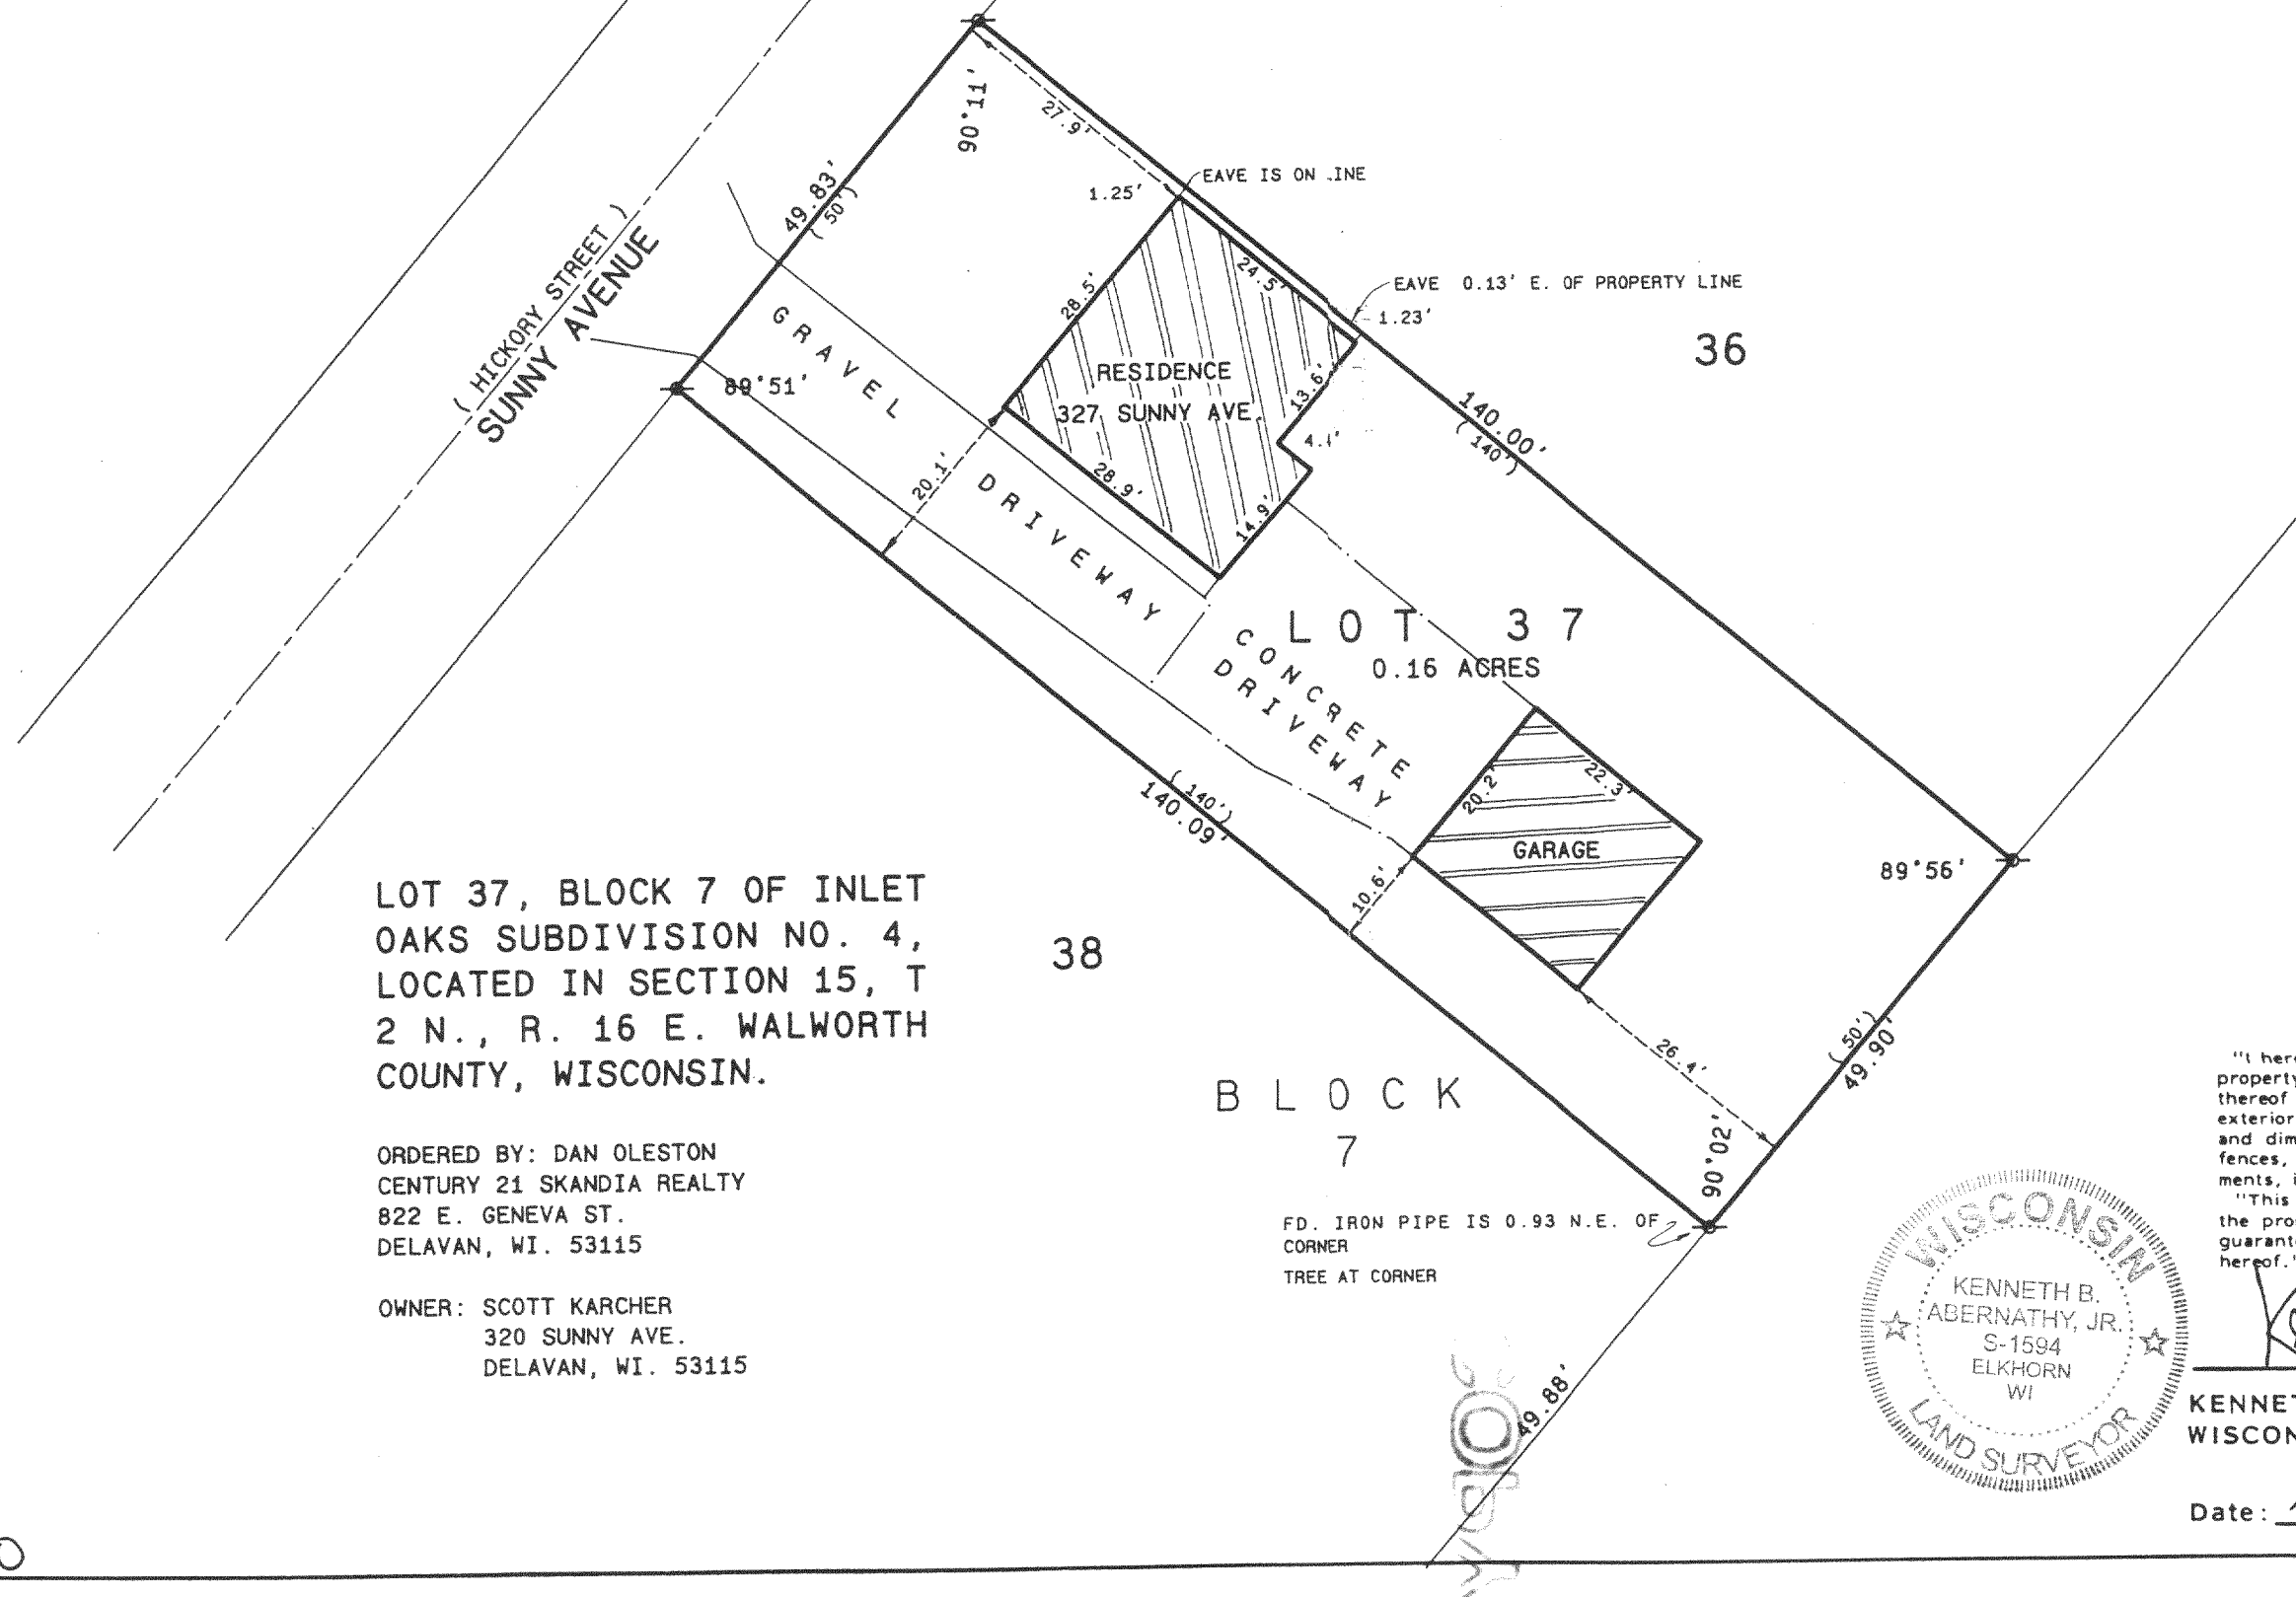

LOT 37, BLOCK 7 OF INLET
OAKS SUBDIVISION NO. 4,
LOCATED IN SECTION 15, T
2 N., R. 16 E. WALWORTH
COUNTY, WISCONSIN.

ORDERED BY: DAN OLESTON
CENTURY 21 SKANDIA REALTY
822 E. GENEVA ST.
DELAVER, WI. 53115

OWNER: SCOTT KARCHER
320 SUNNY AVE.
DELAVER, WI. 53115

BLOCK
7

FD. IRON PIPE IS 0.93 N.E. OF
CORNER
TREE AT CORNER



SCALE: 1"= 20 FEET

Legend

- FOUND IRON PIPE
- FOUND IRON ROD
- FOUND BRASS CAPPED MONUMENT
- FOUND CONCRETE MONUMENT
- CHISEL CUT IN CONCRETE
- SET IRON ROD, 24" LONG, WEIGHING 1.5 LBS./LINEAL FT., 3/4" DIA.
- SET IRON ROD, 30" LONG, WEIGHING 4.5 LBS./LINEAL FT., 1-11/16" DIA.
- (xx) RECORDED AS DIMENSION
- EXISTING FENCE

"I hereby certify that I have surveyed the above described property and that the above map is a true representation thereof and shows the size and location of the property, its exterior boundaries, the location of all visible structures and dimensions of all principal buildings thereon, boundary fences, apparent easements, roadways and visible encroachments, if any."

"This survey is made for the use of the present owners of the property, and also those who purchase, mortgage, or guarantee the title thereto within one year from date hereof."

Kenneth B. Abernathy, Jr.
KENNETH B. ABERNATHY, JR.
WISCONSIN REGISTERED LAND SURVEYOR,
S-1594

Date: MAR. 1ST, 2000 Job No. 00.206

FIN4-70

216-2918