

ABERNATHY and ASSOCIATES

Kenneth B. Abernathy Jr.

Wisconsin Registered Land Surveyor S-1594


W4056 BRAY RD.
ELKHORN, WI. 53121
PHONE: (262) 723-4260 (OFFICE)
(262) 723-7209 (FAX)
Email: abernathy@elknet.net

PLAT OF SURVEY


LOTS 21-24, BLOCK 15, DELAVAN
LAKE VIEW CREST SUBDIVISION,
LOCATED SEC. 31, TOWN 2
NORTH, RANGE 16 EAST, DELAVAN
TOWNSHIP, WALWORTH COUNTY,
WISCONSIN.

ORDERED BY:
TROY SOBERG
102 W. MAIN
FONTANA, WI. 53125

TAX KEY FDLV-80A1 OWNED BY GEORGE SMITH
TAX KEY FDLV-80 OWNED BY JOSEPH LOCALLO

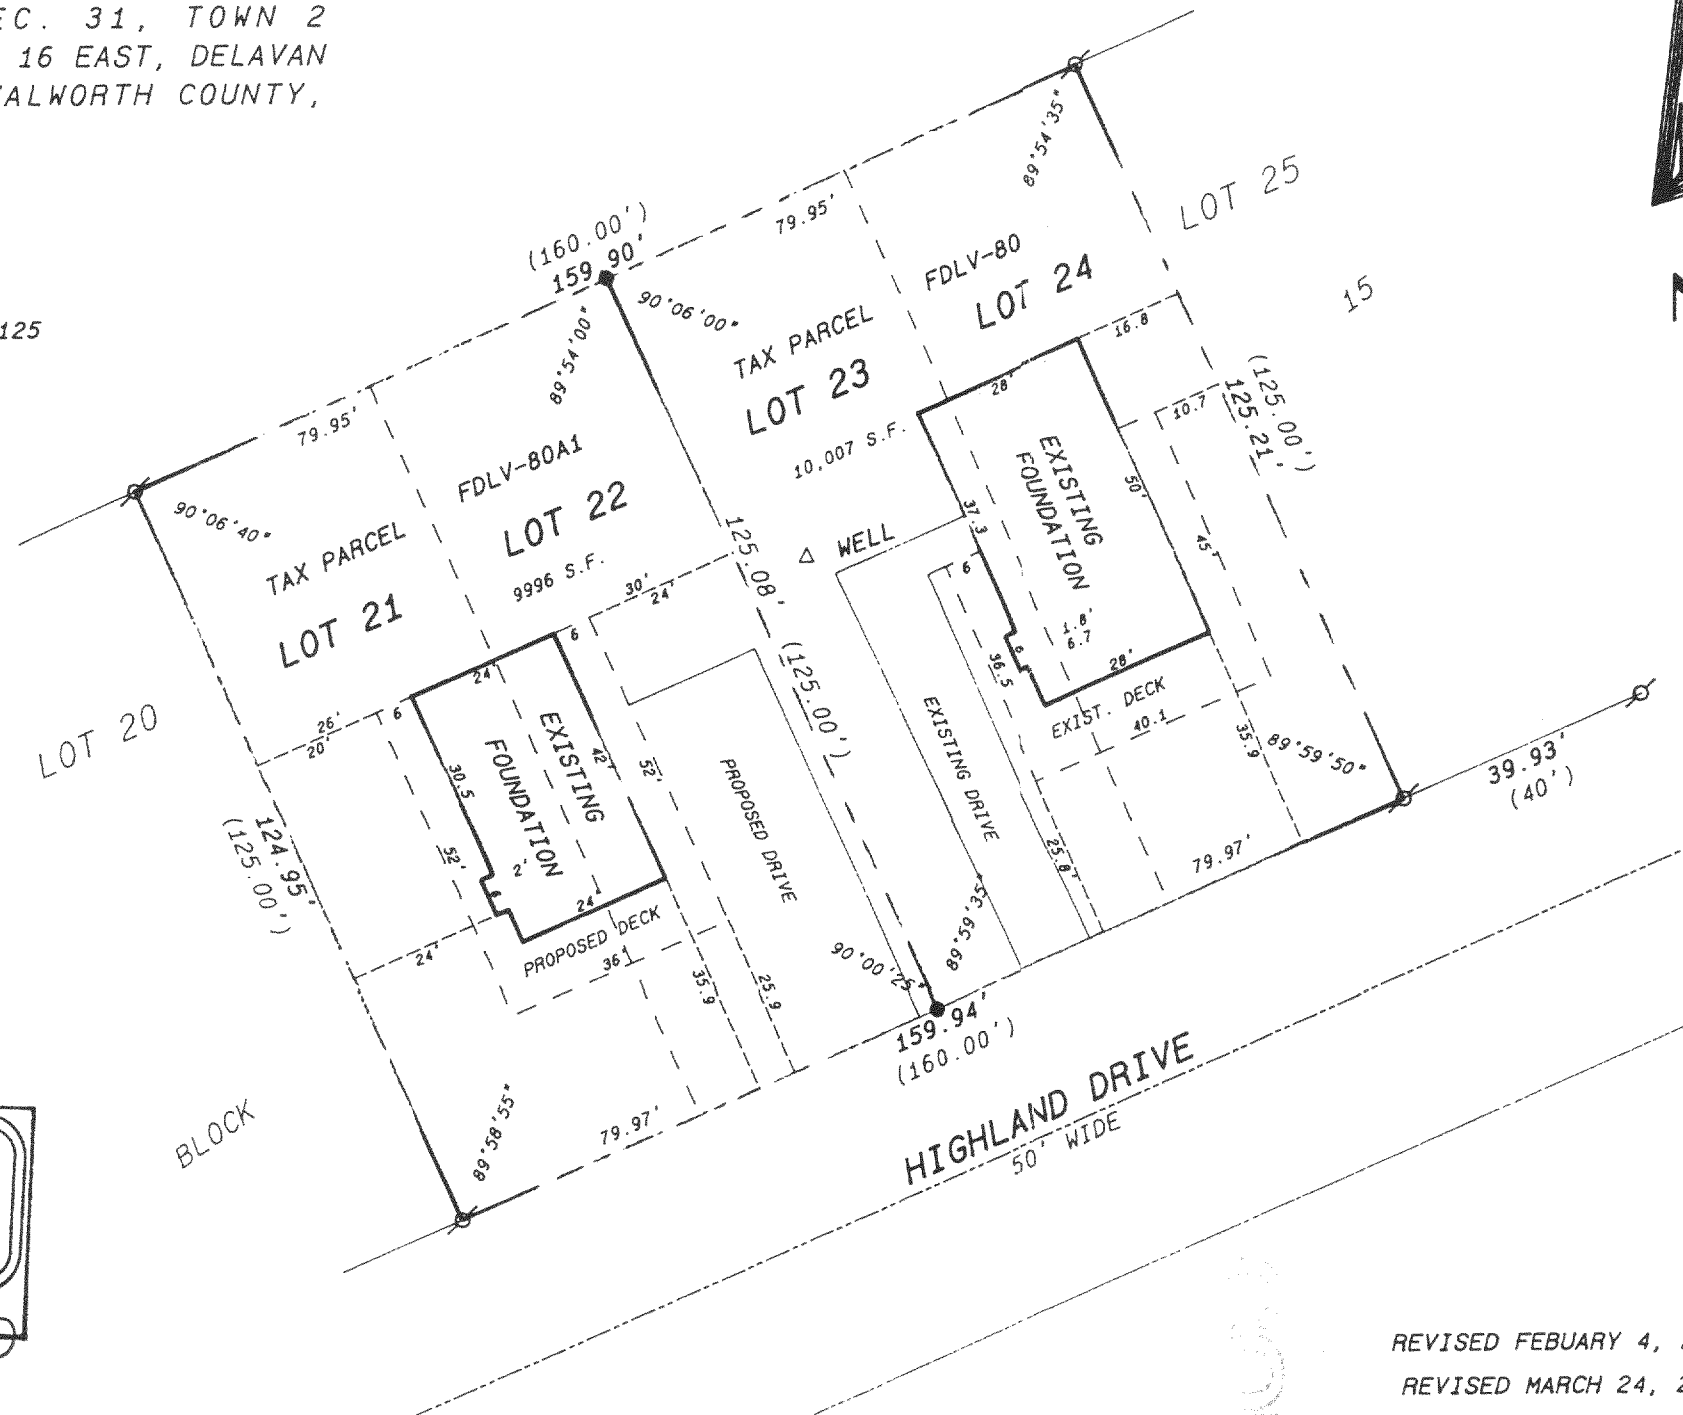

- Legend**
- FOUND IRON PIPE
 - FOUND IRON ROD
 - FOUND BRASS CAPPED MONUMENT
 - ⊗ FOUND CONCRETE MONUMENT
 - + CHISEL CUT IN CONCRETE
 - SET IRON ROD, 24" LONG, WEIGHING 1.5 LBS./LINEAL FT., 3/4" DIA.
 - SET IRON ROD, 30" LONG, WEIGHING 4.5 LBS./LINEAL FT., 1-11/16" DIA.
 - (xx) RECORDED AS DIMENSION
 - x-x- EXISTING FENCE

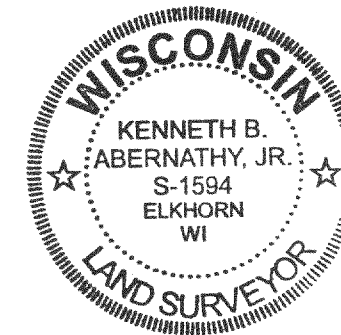


SCALE: 1"=30 FEET

"I hereby certify that the above described property has been surveyed by me or under my direction and that the above map is a true representation thereof and shows the size and location of the property, its exterior boundaries, the location of all visible structures and dimensions of all principal buildings thereon, boundary fences, apparent easements, roadways and visible encroachments, if any."
"This survey is made for the use of the present owners of the property, and also those who purchase, mortgage, or guarantee the title thereto within one year from date hereof."

Kenneth B. Abernathy Jr.
KENNETH B. ABERNATHY, JR.
WISCONSIN REGISTERED LAND SURVEYOR,
S-1594

Date: 9/1/2000 Job No. 99.1208

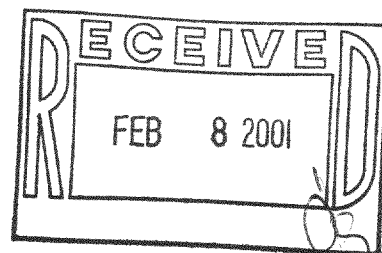

FDLV-80A1
FDLV-80

216-2981

REVISED FEBRUARY 4, 2000
REVISED MARCH 24, 2000
REVISED SEPTEMBER 1, 2000