
PLAT OF SURVEY -OF-

LOT 2 OF CERTIFIED SURVEY MAP NO. , BEING PART OF THE NORTHWEST 1/4 AND THE NORTHEAST 1/4 OF THE NORTHEAST 1/4 OF SECTION 14, AND PART OF THE SOUTHEAST 1/4 AND THE SOUTHWEST 1/4 OF THE SOUTHEAST 1/4 OF SECTION 11, ALL IN TOWNSHIP 2 NORTH, RANGE 16 EAST OF THE FOURTH PRINCIPAL MERIDIAN, IN THE TOWNSHIP OF DELAVAN, COUNTY OF WALWORTH AND STATE OF WISCONSIN.

SURVEY FOR: JAN AND KIM CHRISTIANSON SURVEY ADDRESS: 5381 MOUND ROAD

NOTE: CENTER LINE PER 1845 EDWARD NORRIS SURVEY.

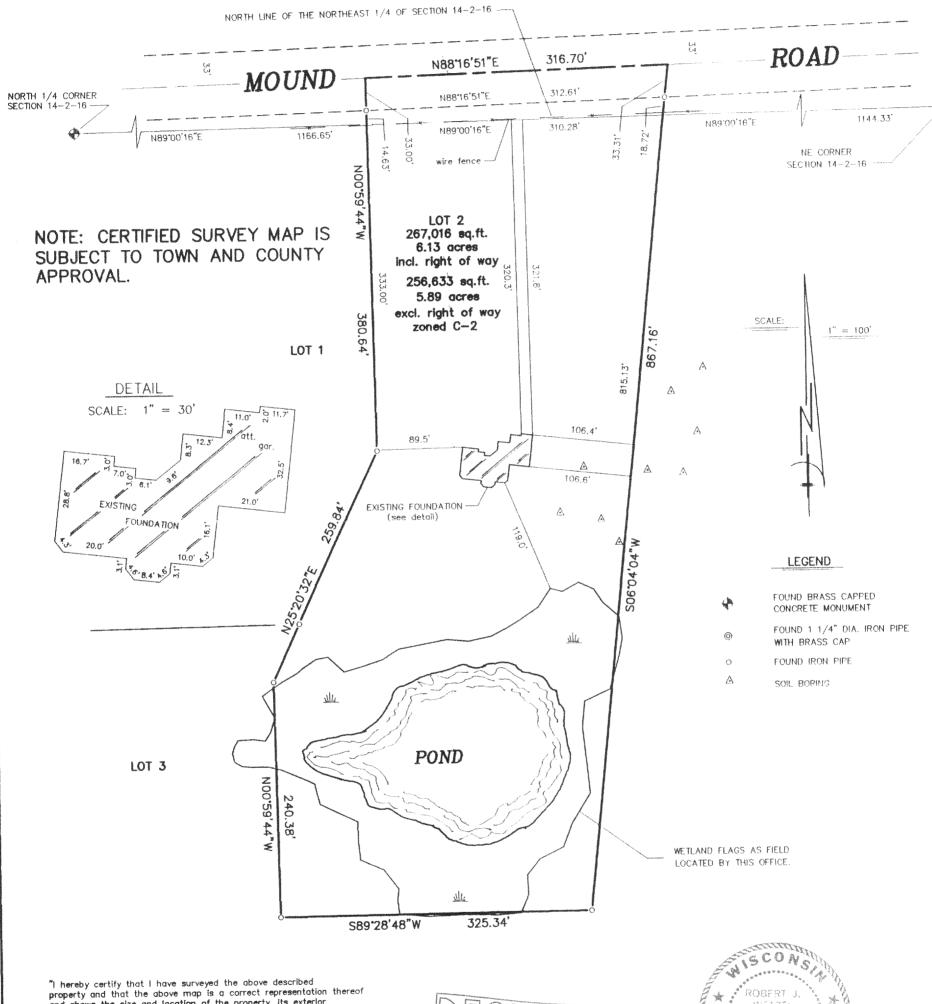

"I hereby certify that I have surveyed the above described property and that the above map is a correct representation thereof and shows the size and location of the property, its exterior boundaries, the location of all visible structures and dimensions of all principal buildings thereon, boundary fences, apparent easements, roadways and encroachments, if any."

"This survey is made for the use of the present owners of the property, and those who purchase, mortgage, or guarantee the title thereto within one year from date hereof."





THIS IS NOT AN ORIGINAL PRINT

UNLESS THIS SEAL IS RED.



B.W. SURVEYING, INC.

LAND SURVEYS MAPPING AND PLANNING 412 N. PINE STREET BURLINGTON, WI 53105 (262) - 767 - 0225

4931 JOB NUMBER

NOVEMBER 20, 2001 DATE