
ABELL SURVEYING & MAPPING

1140 SEQUOIA STREET . DELAVAN. WISCONSIN 53115 262-728-6737

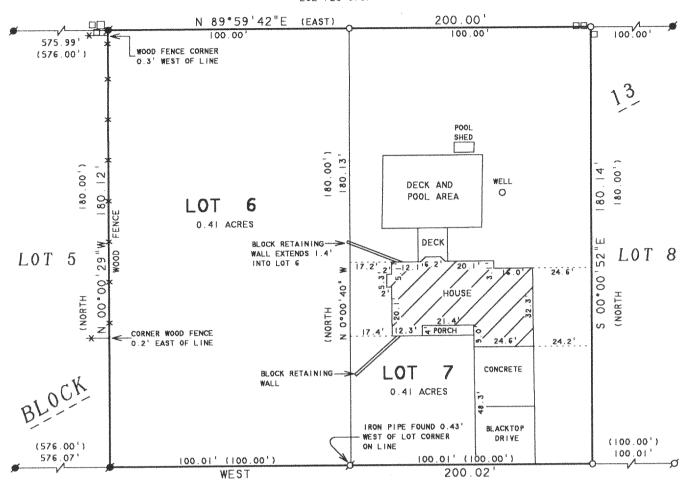

VALENCIA

DRIVE

CEIV

MAY 1 0 2002

ORDERED BY: WASSEL, KILKENNY, DANZ, MISTRIOTY & LETTENBERGER 125 N. SECOND STREET

P.O. BOX 447 DELAVAN, WI 53115

NOTE: BEARINGS ARE REFERENCED TO THE RECORDED SUBDIVISION PLAT.





LOTS 6 AND 7. BLOCK 13. INLET OAKS SUBDIVISION NO. 5, LOCATED IN T2N. RIGE. WALWORTH COUNTY. WISCONSIN



SCALE | " = 40 '

LEGEND

-IRON PIPE FOUND -IRON ROD FOUND

-IRON PIPE SET ☐☐ -UTILITY PEDS)-RECORDED AS

REVISED: JANUARY 31, 2002 ORDERED BY: JOEY TORKELSON

512 VALENCIA DR DELAVAN, WI 53115 I HEREBY CERTIFY THAT I HAVE SURVEYED THE ABOVE DESCRIBED PROPERTY AND THAT THE ABOVE MAP IS A TRUE REPRESENTATION THEREOF AND SHOWS THE SIZE AND LOCATION OF THE PROPERTY. ITS EXTERIOR BOUNDARIES. THE LOCATION OF ALL VISIBLE STRUCTURES AND DIMENSIONS OF ALL PRINCIPAL BUILDINGS THEREON. BOUNDARY FENCES. APPARENT EASEMENTS, ROADWAYS AND VISIBLE ENCROACHMENTS, IF ANY, TO THE BEST OF MY KNOWLEDGE AND BELIEF.

THIS SURVEY IS MADE FOR THE USE OF THE PRESENT OWNERS OF THE PROPERTY, AND ALSO THOSE WHO PURCHASE, MORTGAGE, OR GUARANTEE THE TITLE THERETO WITHIN ONE (I) YEAR FROM DATE HEREON.

DAVID F. ABELL WISCONSIN REGISTERED LAND SURVEYOR, S-1596

DATE NOTE: THIS IS NOT A CERTIFIED COPY UNLESS SEALED

FINS- 32 FINS- 33

216-3171