


1140 SEQUOIA STREET • DELAVAN, WISCONSIN 53115
262-728-6737

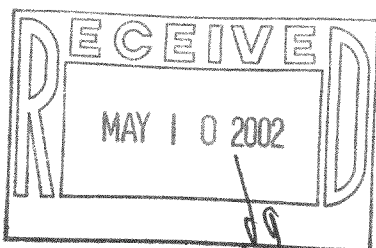

— MOST NORTHERLY CORNER OF LOT 4.
CERTIFIED SURVEY MAP NO. 13

CERTIFIED SURVEY MAP NO. 13

(NORTH 1/4 CORNER →
SECTION 2-2-16)

(CARDINAL DRIVE)

142.85'
(54.45')

S 41°42'34" E

LOT 2

MAP NO. 13

160.00

LOT

AREA 0.79 ACRES

BLACKTOP DRIVE

197.00' OVERHEAD 285.40

PLAT OF SURVEY OF

HI GWAY
WAY *15)

COMMENCING AT THE NORTH 1/4 CORNER OF SECTION 2, T2N, R16E, WALWORTH COUNTY, CONSIDERED; THENCE DUE SOUTH 1875.46 FEET TO A POINT IN THE NORTH LINE OF STATE TRUNK #15 AND THE PLACE OF BEGINNING OF THE EINAFTER DESCRIBED; THENCE N 48°18' E ALONG THE NORTH LINE OF SAID HIGHWAY; THENCE NORTH 214.29 FEET; THENCE S 48°18' W THENCE DUE SOUTH 214.29 FEET TO THE PLACE

ALSO LOT 1 OF CERTIFIED SURVEY MAP NO. 13, RECORDED IN
VOLUME 1 OF CERTIFIED SURVEYS, ON PAGE 13, DOCUMENT NUMBER
570019, WALWORTH COUNTY RECORDS.

I HEREBY CERTIFY THAT I HAVE SURVEYED THE ABOVE DESCRIBED PROPERTY AND THAT THE ABOVE MAP IS A TRUE REPRESENTATION THEREOF AND SHOWS THE SIZE AND LOCATION OF THE PROPERTY, ITS EXTERIOR BOUNDARIES, THE LOCATION OF ALL VISIBLE STRUCTURES AND DIMENSIONS OF ALL PRINCIPAL BUILDINGS THEREON, BOUNDARY FENCES, APPARENT EASEMENTS, ROADWAYS AND VISIBLE ENCROACHMENTS, IF ANY, TO THE BEST OF MY KNOWLEDGE AND BELIEF.

THIS SURVEY IS MADE FOR THE USE OF THE PRESENT OWNERS OF THE PROPERTY, AND ALSO THOSE WHO PURCHASE, MORTGAGE, OR GUARANTEE THE TITLE THERETO WITHIN ONE (1) YEAR FROM DATE HEREON.

DAVID F. ABELL
WISCONSIN REGISTERED LAND SURVEYOR. S-1596

March 6, 2002

DATE _____ JOB NUMBER - 02026
NOTE: THIS IS NOT A CERTIFIED COPY UNLESS SEALED.

ORDERED BY: JAMES BARR
5486 STATE ROAD "11"
ELKHORN, WI 53121

SCALE 1" = 30'

LEGEND

- Ø - IRON PIPE FOUND
- ⦿ - IRON ROD FOUND
- ⊙ - IRON BAR FOUND
- - 1" DIA. IRON PIPE SET
- - 3/4" IRON ROD SET
- ▲ - SOIL BORING
- ⌋ - SATELLITE DISH
- ⊕ - HIGHWAY PI MONUMENT
- CS - CONCRETE STOOP
- () - RECORDED AS

1000' 23" W
(SOUTH)

TAX PARCEL
FD-2-4E

STATE

HIGHWAY REFERENCE LINE

FROM DATE HEREON:

Daniel F. Rhall

DATE _____ JOB NUMBER - _____
NOTE: THIS IS NOT A CERTIFIED COPY UNLESS SEALED

216-3179
FD-2-4E FA-13-1