

PLAT OF SURVEY OF

LOTS 1 AND 2, WILLOW POINT PARK, LOCATED  
IN T2N, R16E, WALWORTH COUNTY, WISCONSIN.

NOTE 1: BEARINGS ARE REFERENCED TO  
CERTIFIED SURVEY MAP NO. 1511.

NOTE 2: LOCATION OF DRIVEWAY IS  
APPROXIMATE DUE TO SNOW  
COVER ON DATE OF SURVEY.

TAX PARCEL  
FD-29-22A


TAX PARCEL  
FWI-1  
AREA 1.35 ACRES ±



SCALE 1"=30'

LEGEND

- - IRON PIPE FOUND
- - IRON ROD FOUND
- - CONCRETE MONUMENT FOUND
- - CUT CROSS IN CONCRETE FOUND
- - FENCE CORNER POST
- - IRON PIPE SET, found 8/7/02
- - IRON ROD SET, found 8/7/02
- BE - BASEMENT ENTRY
- △ - UTILITY POLE
- - GUY WIRE
- - OVERHEAD UTILITY LINES
- - UTILITY PED.
- XX - WIRE FENCE
- MH - MANHOLE COVER
- ( ) - RECORDED AS

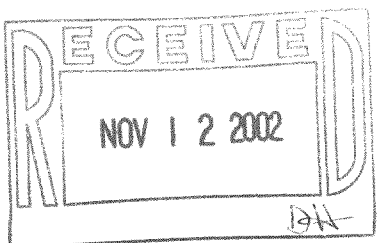

I HEREBY CERTIFY THAT I HAVE SURVEYED THE ABOVE DESCRIBED PROPERTY AND THAT THE  
ABOVE MAP IS A TRUE REPRESENTATION THEREOF AND SHOWS THE SIZE AND LOCATION OF  
THE PROPERTY, ITS EXTERIOR BOUNDARIES, THE LOCATION OF ALL VISIBLE STRUCTURES  
AND DIMENSIONS OF ALL PRINCIPAL BUILDINGS THEREON, BOUNDARY FENCES, APPARENT  
EASEMENTS, ROADWAYS AND VISIBLE ENCROACHMENTS, IF ANY, TO THE BEST OF MY  
KNOWLEDGE AND BELIEF.

THIS SURVEY IS MADE FOR THE USE OF THE PRESENT OWNERS OF THE PROPERTY, AND ALSO  
THOSE WHO PURCHASE, MORTGAGE, OR GUARANTEE THE TITLE THERETO WITHIN ONE (1) YEAR  
FROM DATE HEREON.

David F. Abell  
DAVID F. ABELL  
WISCONSIN REGISTERED LAND SURVEYOR, S-1596

ORDERED BY: KEEFE REAL ESTATE  
822 E. GENEVA STREET  
DELAVAN, WI 53115

REVISED AND RECERTIFIED: AUGUST 7, 2002

February 1, 1999

DATE: February 1, 1999  
JOB NUMBER: 97091A  
NOTE: THIS IS NOT A CERTIFIED COPY UNLESS SEALED.

FWI-1

216-3276