


GEORGE T. DUNHAM
SURVEYING & SUBDIVIDING
DELAVER, WISCONSIN

N

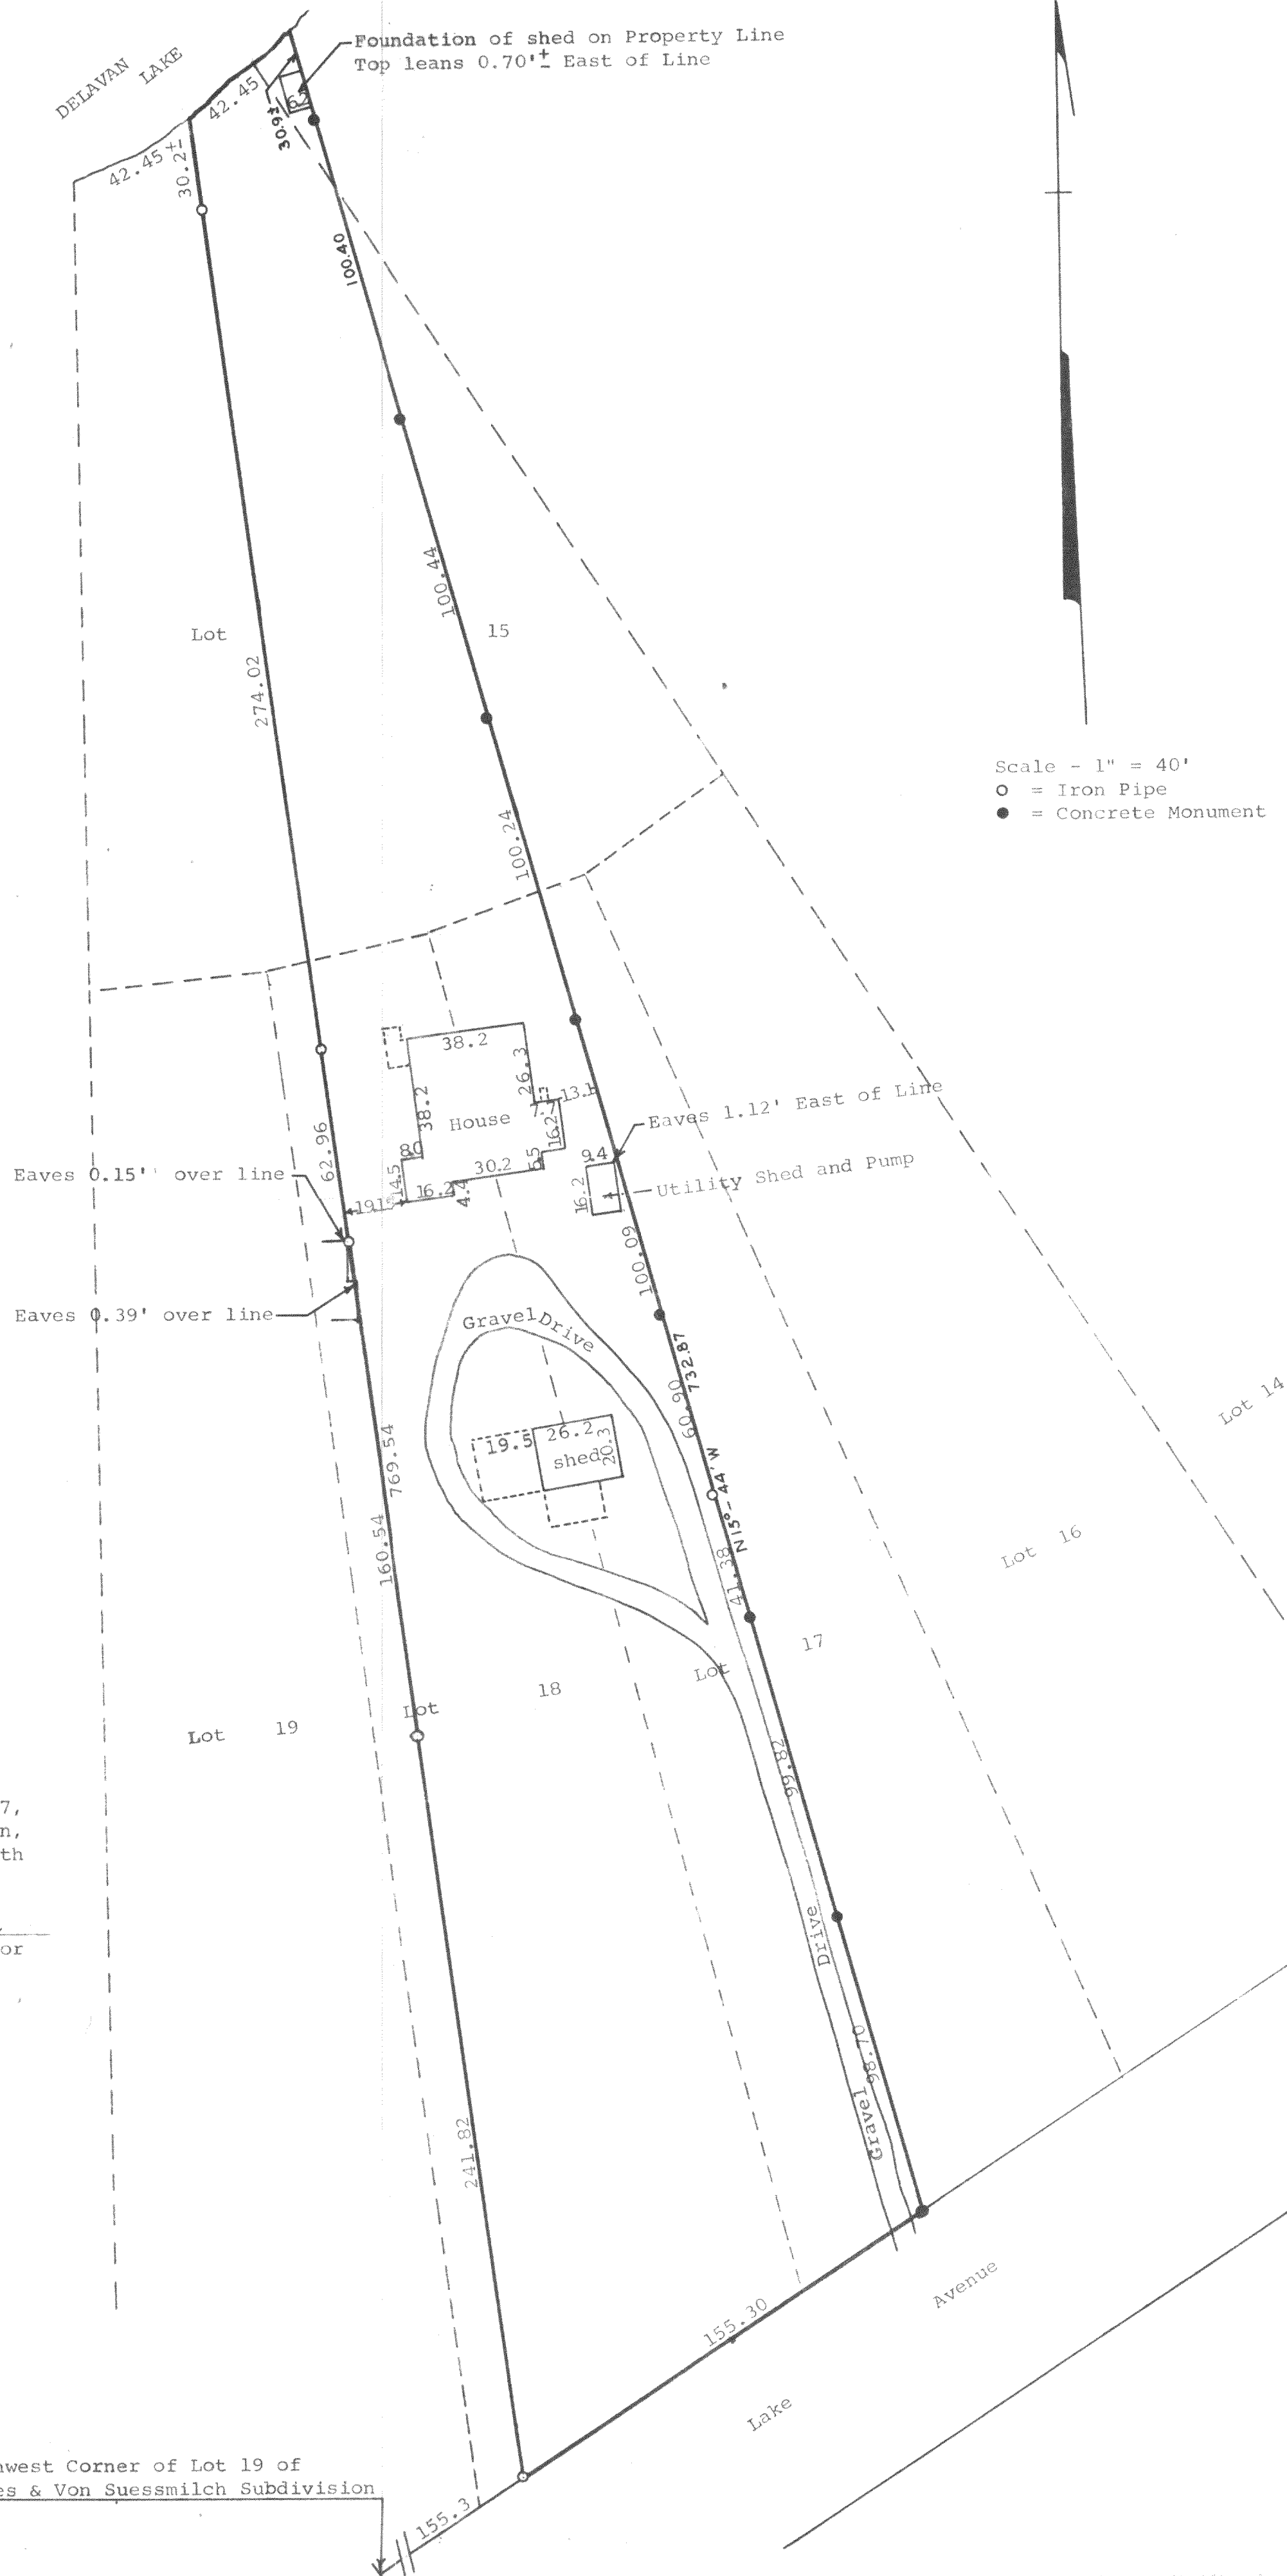

Plat of survey of part of Lots 14, 15, 16, 17,
and 18 of Barnes & Von Suessmilch Subdivision,
located in Section 33, T 2 N, R 16 E, Walworth
County, Wisconsin.
October, 1969

George T. Dunham
George T. Dunham, Surveyor

FBA-8
11 9
11 10