


GEORGE T. DUNHAM
SURVEYING & SUBDIVIDING
DELAVAN, WISCONSIN



Scale - 1" = 30'
○ = Iron Pipe

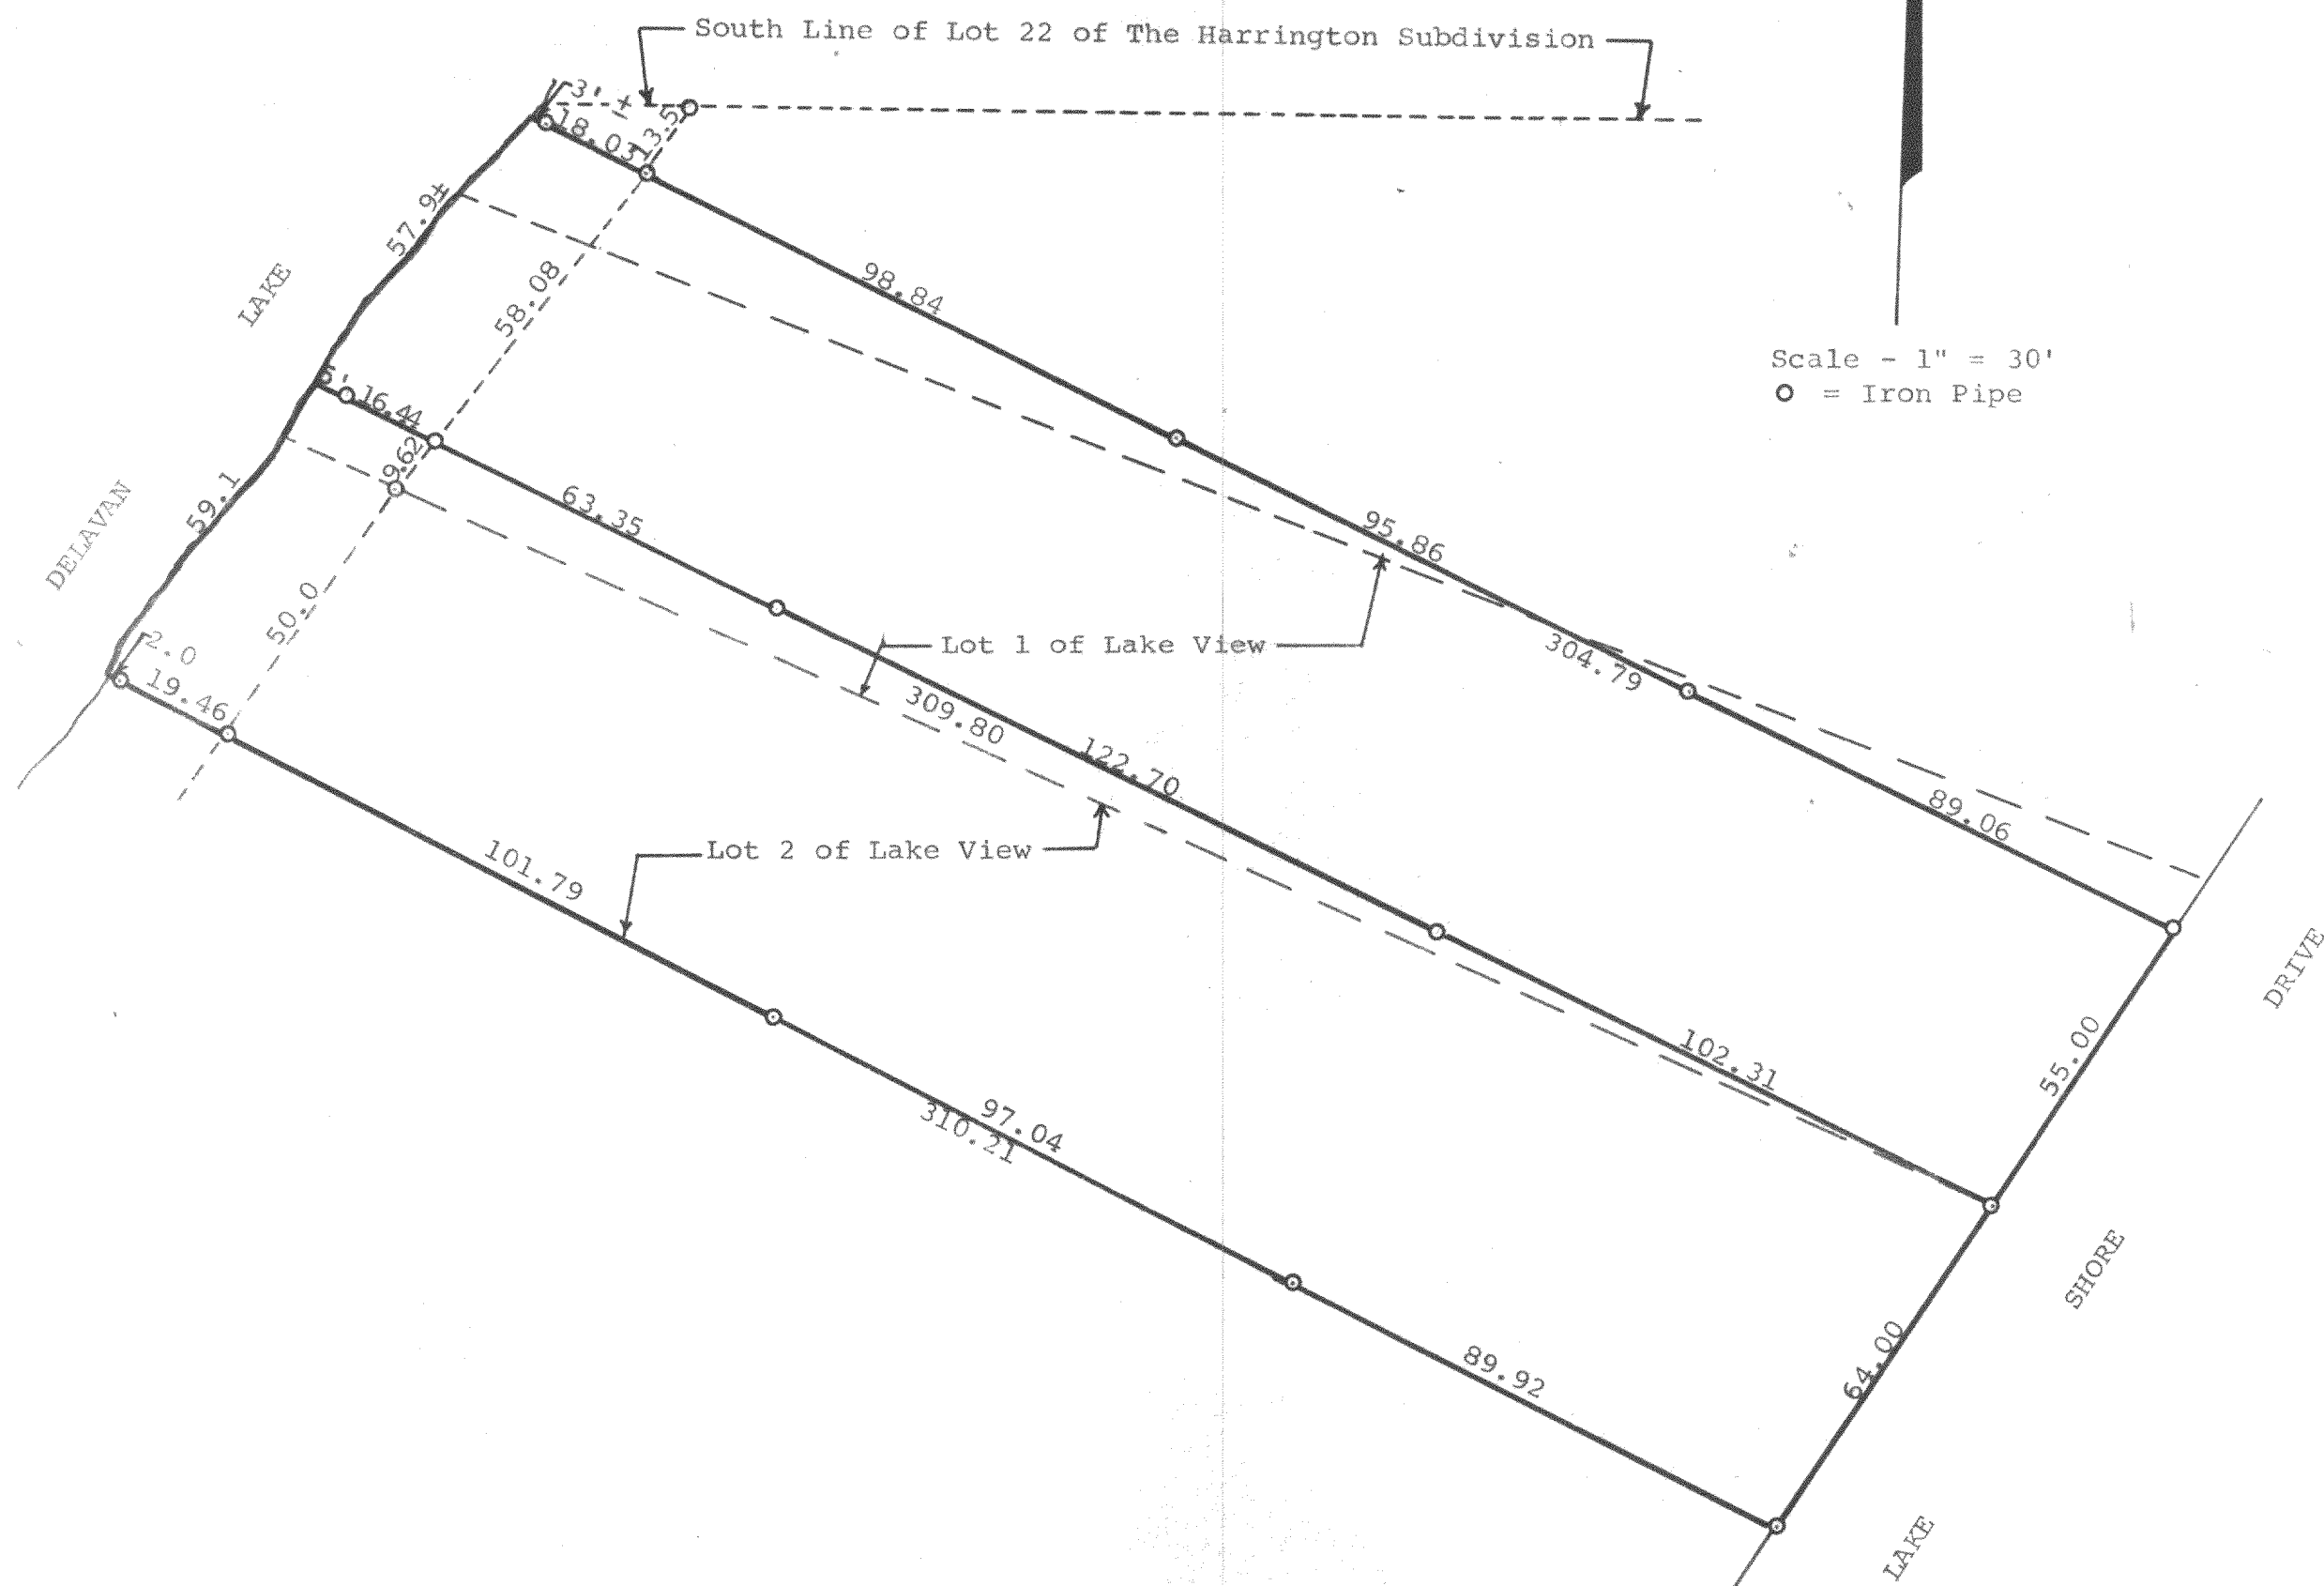

FLAP-1
FLAP-2

Plat of survey of Lots 1 and 2 of Lake View and a parcel of land
located to the North of said Lot 1 in Section 27, T 2 N, R 16 E,
Walworth County, Wisconsin.
September 17, 1969

George T. Dunham
George T. Dunham, Surveyor

216-337