
DUNHAM SURVEYING, S.C.
SURVEYING & SUBDIVIDING
DELAVAN, WISCONSIN 53115

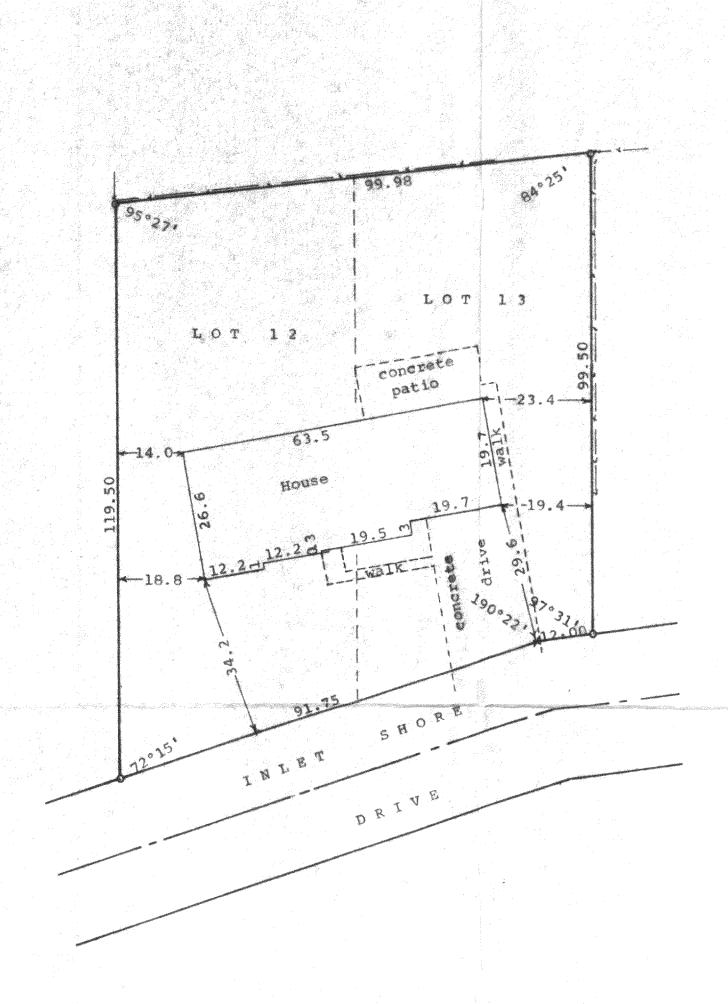

Survey ordered by: Century 21 Skandia Realty, Inc. 802 East Geneva Street Delavan, WI 53115

STATE OF WISCONSIN) SS

I, George T. Dunham, Surveyor, certify that I have surveyed the property described as follows:

Lots 12 and 13 in Block 7 of Inlet Oaks Subdivision No. 4, located in Section 15, T 2 N, R 16 E, Walworth County, Wisconsin, and that the plat shown lereon is a correct representation thereof and shows the size and location of the property, its exterior boundaries, the location of all visible structures and dimensions of all principal buildings thereon, boundary fences, apparent easements, roadways and visible encreachments, if any, and that I have surveyed the property hereon described according to the official records, to the best of my knowledge and belief.

November 20, 2000

George T. Dunham, Surveyor



